



CITY OF TACOMA
Tacoma Power / Generation

ADDENDUM NO. 2

DATE: February 26, 2021

REVISIONS TO:
Request for Bids Specification No. PG20-0314
Cowlitz Falls Barrier Dam Repair Project

NOTICE TO ALL BIDDERS:

This addendum is issued to clarify, revise, add to or delete from, the original specification documents for the above project. This addendum, as integrated with the original specification documents, shall form the specification documents. The noted revisions shall take precedence over previously issued specification documents and shall become part of this contract.

REVISIONS TO THE SUBMITTAL DEADLINE:

The submittal deadline has been changed to 11:00 a.m., Pacific Time, Tuesday, March 23, 2021.

REVISIONS TO THE GENERAL INFORMATION AND REQUIREMENTS:

Site visit to the left bank is scheduled for Friday, March 5, 2021.

REVISIONS TO THE SPECIAL PROVISIONS:

Replace Section 01010 Summary of Work, Page 3 with revised page: Liquidated damages limit added.

Replace Section 46 80 10 Bulkhead Gate, Page 4 with revised page: Addition of acceptable manufacturer.

QUESTION AND ANSWER RESPONSES:

1. Question: Can work take place below OHW and outside the inwater work areas?
 - a. Answer: Yes, temporary work will be needed to access and construct the cofferdam. Upstream of the Dam the AWS may not be blocked. Downstream of the dam the Right Fish Entrance must remain clear.
2. Question: Please provide soils reports or boring logs in the vicinity of the barrier dam if possible.
 - a. Answer: Tacoma Power can confirm that the top 10 feet are gravels. We are currently locating the soils/geology reports in the offsite archive. If information is found, we will provide it in another addendum.
3. Question: Can there be a site visit to view the left abutment?
 - a. Answer: Yes, it is being scheduled, see procurement requirements.

4. Question: Please provide the as-built drawings of the Barrier Dam.
 - a. Answer: As-builts are provided as attachment 2.
5. Question: Please provide all the permits stated in Section 01040- 1.3 Permits
 - a. Answer: Addendum 1 included final or draft copies of these permits as appropriate.
6. Question: Section 01040 states that the in-water work windows be phased over three years. Can these in-water window years be altered/ re-sequenced by the contractor to best fill their river diversion plan?
 - a. Answer: Yes, however consider that stage 3 has a shorter duration due to being adjacent to the right (and only functional) fish entrance. Access to the right fish entrance must not be impeded.
7. Question: Can the Gravel Augmentation placement be performed outside the In-water window?
 - a. Answer: Yes, Gravel Augmentation can be performed outside the In-water work window.
8. Question: Section 01400 discusses quality control and states in 1.2 A that "Construction inspection and testing for the City will be performed by a City employee or others as the City may designate and as the construction situation may dictate". Section 01 40 00 seems to indicate that the contractor will be responsible for quality control. Further in 3.2 G the specification states that "The required tests and frequencies are shown in Table 2". I cannot find a Table 2. Is it the intent for the City to be responsible for onsite testing and inspection?
 - a. Answer: The Contractor is responsible for performing Quality Control per section 01 40 00. The Engineer is performing Quality Assurance and selected onsite material testing for QA purposes. City of Tacoma will be performing Quality Verification. Section 3.2 G should read: "The required test and frequencies are shown in Table 1."
9. Question: Section 01040, Paragraph 1.3 – Permits lists all the permits obtained by the City. Are these permits available to review for bidding purposes?
 - a. Answer: Addendum 1 included final or draft copies of these permits as appropriate.
10. Question: Is the pre-bid meeting for the above referenced project mandatory?
 - a. Answer: Pre-bid meeting is not mandatory. The site visits are not mandatory.
11. Question: The Specifications require the Contractor to provide a Water Control plan for both the Engineer and FERC approval. These details will require considerable engineering to prepare a plan and proper estimate for this work during the bidding phase. With the current 3 week bid period provided this will be very difficult to accomplish. It is requested that you extend the bid schedule by 4 weeks in order for bidding contractors to properly evaluate, develop and estimate these requirements.
 - a. Answer: Bid Period was extended 3 weeks in Addendum 1 to March 23rd.

12. Question: Please provide the date for the last day of questions.
a. Answer: In order to prepare the final addendum, it is requested that all questions be submitted by March 10th.
13. Question: Please provide the date for the last issuance of the final addendum.
a. Answer: The last addendum must be issued 7 days prior to the bid date. At this time it is planned for March 16th.
14. Question: Is there a limit on liquidated damages?
a. Answer: See specification change section.
15. Question: Are aeration pipes plugged?
a. Answer: Assume that the existing aeration pipes are plugged with sand/organics.

REVISIONS TO THE PLANS:

Addition of barrier dam as-built drawings:

• MA2775	Mossyrock Salmon Hatchery Barrier Dam	Standard Details Sheet 1
• MA2776	Mossyrock Salmon Hatchery Barrier Dam	Standard Details Sheet 2
• MA2778	Mossyrock Salmon Hatchery Barrier Dam	Excavation Sheet 1
• MA2779	Mossyrock Salmon Hatchery Barrier Dam	Excavation Sheet 2
• MA2782	Mossyrock Salmon Hatchery Barrier Dam	Fish Barrier, Abutments, and Entrance Structures
• MA2783	Mossyrock Salmon Hatchery Barrier Dam	Fish Barrier Concrete and Reinforcements
• MA2784	Mossyrock Salmon Hatchery Barrier Dam	Left Abutment Concrete and Reinforcement
• MA2785	Mossyrock Salmon Hatchery Barrier Dam	Right Abutment and Entrance Struct. Concrete and Reinforcement Sheet 1
• MA2786	Mossyrock Salmon Hatchery Barrier Dam	Right Abutment and Entrance Struct. Concrete and Reinforcement Sheet 2
• MA2788	Mossyrock Salmon Hatchery Barrier Dam	General Plan Fish Ladders and Transportation Channel
• MA2789	Mossyrock Salmon Hatchery Barrier Dam	Fish Ladders Concrete and Reinforcement Sheet 1
• MA2790	Mossyrock Salmon Hatchery Barrier Dam	Fish Ladders Concrete and Reinforcement Sheet 2
• MA2792	Mossyrock Salmon Hatchery Barrier Dam	Miscellaneous Metals Sheet 1
• MA2793	Mossyrock Salmon Hatchery Barrier Dam	Miscellaneous Metals Sheet 2

Specification PG20-0314F
Addendum 4
February 26, 2021

• MW3797	Mossyrock Salmon Hatchery Barrier Dam	Conduit, Grounding & Lighting Layout Sheet 1
----------	---------------------------------------	--

REFERENCE DOCUMENTS:

The following reference documents have been provided as part of this addendum:

- Attachment G Barrier Dam Forebay Photos (2,500 CFS and 6,300 CFS)

NOTE: Acknowledge receipt of this addendum by initialing the corresponding space as indicated on the signature page. Vendors who have already submitted their bid/proposal may contact the Purchasing Division at 253-502-8468 and request return of their bid/proposal for acknowledgment and re-submittal.

Or, a letter acknowledging receipt of this addendum may be submitted in an envelope marked Request for Bids Specification No. PG20-0314F Addendum No. 2. The City reserves the right to reject any and all bids, including, in certain circumstances, for failure to appropriately acknowledge this addendum.



Patsy Best, Procurement and Payables Manager
Finance/Purchasing Division

Cc: Tim Nordstrom, Power Engineer IV, Tacoma Power / Generation
Toby Brewer, Assistant Generation Manager, Tacoma Power / Generation

For this intermediate milestone, the amount of liquidated damages set forth of the General Provision 3.14 is hereby modified to \$10,000 per day, limited to a maximum of \$250,000.

1.5 SPECIFICATION FORMAT

This specification is written and formatted for use with Public Works specifications and is numbered to be consistent with other specifications, including Construction Specifications Institute (CSI) format, as modified by the City.

It is not intended to indicate what work is to be accomplished by various subcontractors on the project. In all cases, the City's contract is with one (1) general contractor and it is the general contractor's responsibility to insure all work required to provide a complete and operational facility is included in their bid.

When possible, the City has tried to reference work which should be included with various trades, but it is the contractor's responsibility to ensure all work is properly coordinated. The numbering system in the Special Provisions Section reflects standard provisions written by the City and assigned constant numbers. Thus, gaps will appear when specific sections are not used.

1.6 CONTRACT WORK TIMES

Work Hour Restrictions: The contractor should limit the upland work on the left bank (looking downstream) in the months of May and June such that work on the left bank does not start until two hours after sunrise and work has stopped two hours before sunset (i.e., approximately 8am-6:20pm in May and 7:30am-7pm in June). Beginning in July and extending to December there are no restrictions on work hours.

If the contractor elects to work on a Saturday, Sunday, holiday or longer than the designated contract work times, such work shall be considered overtime work. On all such overtime work, a City engineer or their inspector must be present. The contractor shall reimburse the City for the full amount of the costs for City employees who must work any such overtime hours. It shall be the engineer's decision as to when an inspector is required. For the purpose of estimation of reimbursement of City employee's overtime, the bidder shall budget \$80.00 per hour.

However, if the City orders work to be performed on overtime, all City employees' overtime costs will be at no expense to the contractor. The City will not require reimbursement for overtime hours worked by the City for inspection as detailed in the General Provisions if the conditions of this paragraph are met to the satisfaction of the engineer.

1.7 QUALIFICATION OF CONTRACTORS

A. QUALIFIED CONTRACTORS

Only contractors with management, employees, and staff experienced in the type of work required by this specification, and with a record of successful completion of projects of similar scope, complexity, and overall cost will be considered. The bidder must complete the Contractor's Record of Prior Contracts form attached to this specification at the time of submitting their bid.

Additional materials are required to provide proof of qualifications to perform the work. See Section 01010, 1.9 Evaluation of Bids The City will be the sole judge of the bidder's ability to meet the requirements of this paragraph. Bidders past work will be judged in complexity of job, time of completion, organization, and other factors that may indicate the abilities of the contractor.

Submit to the engineer within ten (10) calendar days following execution of the contract documents, a list of all subcontractors, including each subcontractor's address, telephone number, and contact person to be used on this project.

2.2 ACCEPTABLE MANUFACTURERS

A. The following manufacturers are acceptable for the design and fabrication of the bulkhead gate and hoist. All other manufacturers not listed subject to approval by the City based qualifications required for substitutions.

1. EDCO Inc. – Mt Vernon, WA.
2. Jesse Engineering – Tacoma, WA.
3. K&N Electric – Spokane Valley, WA.
4. Rodney Hunt-Fontaine – Orange, MA.
5. Selway Corp. – Stevensville, MT.
6. Transco Industries Inc. – Portland, OR.
7. Vigor (Oregon Iron works) – Clackamas OR.

8. Thompson Metal Fab. – Vancouver, WA.

9. Greenberry – Vancouver, WA.

B. Substitution for gate manufacturers shall have no less than ten years' experience designing and fabricating similar projects. The manufacturer shall be subject to approval by the City based on consideration of submitted qualifications showing evidence of completing similar gates including owner with contact information, location, capacity, description of gate, and date of installation.

2.3 BULKHEAD GATE AND HOIST SUPPORT FRAME ASSEMBLY

A. CONFIGURATION

The Bulkhead Gate shall conform to the requirements indicated below:

Component/Condition Requirement

No. Gates	1
Nominal Size (feet)	14 high / 5.3 top width / 4.7 bottom width
Max. Head @ Invert (feet)	15
Actuator	2-ton chain hoist


B. OPERATION

Gate shall be raised and lowered with no differential across the bulkhead gate.



C. MATERIALS

Material in the bulkhead gate and appurtenances shall conform to the requirements of the applicable specifications listed below for the alloy, grade, type, or class of material and the condition and finish appropriate to the structural and operational requirements.

Material	ASTM Specification
Steel Plates, and Bars	A572, Grade 50
Wide-Flange Shapes	A992
Hollow Structural Shapes	A500, Grade B
Other Structural Shapes (M, S, C, MC, L)	A36
Stainless Steel Bottom Sill Plate, guides, and other Components Embedded in Concrete	A269, A276, or A666 Type 304 or 304L (for better weldability)
Stainless Steel Bolts and Nuts	F593 or F594, Type 304

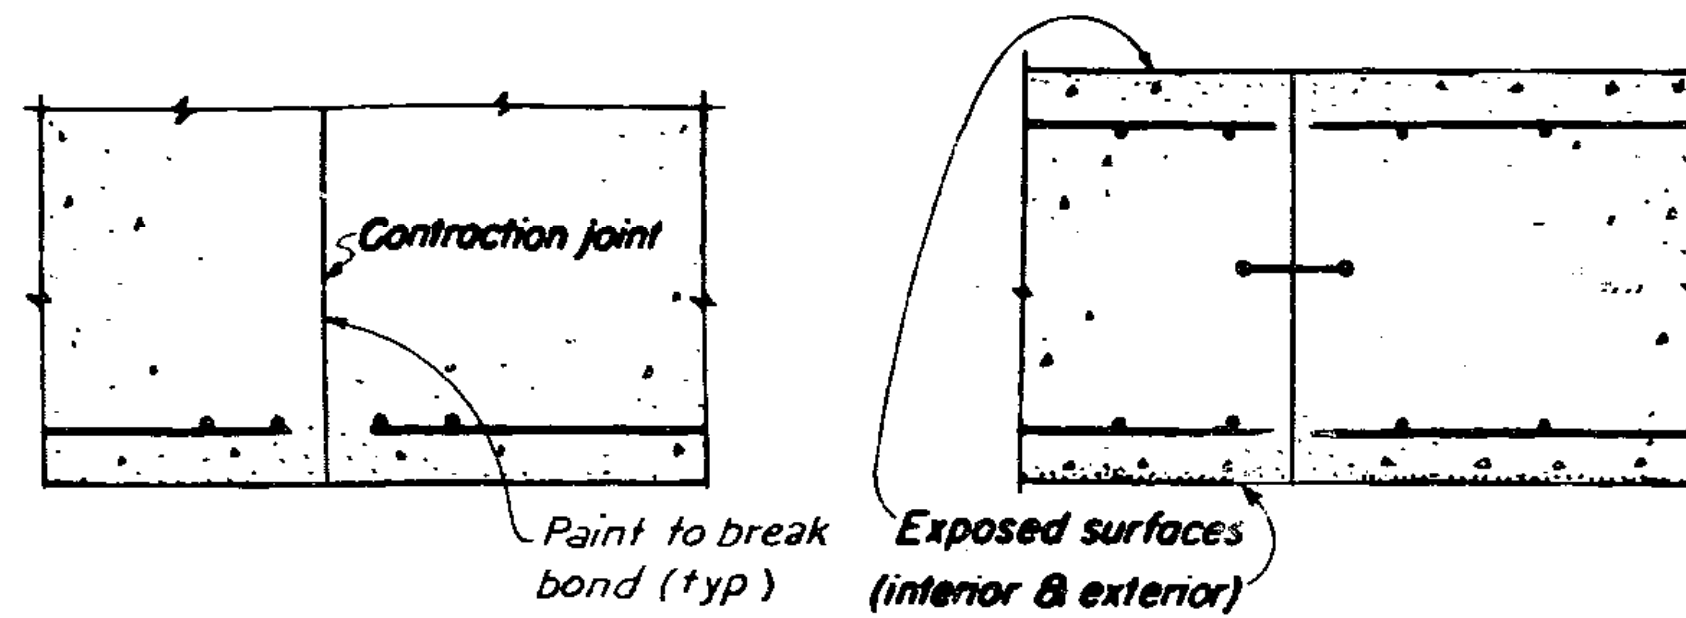


MASS CONCRETE
CONTRACTION JOINTS
(Reinforcement stops at contraction joints)

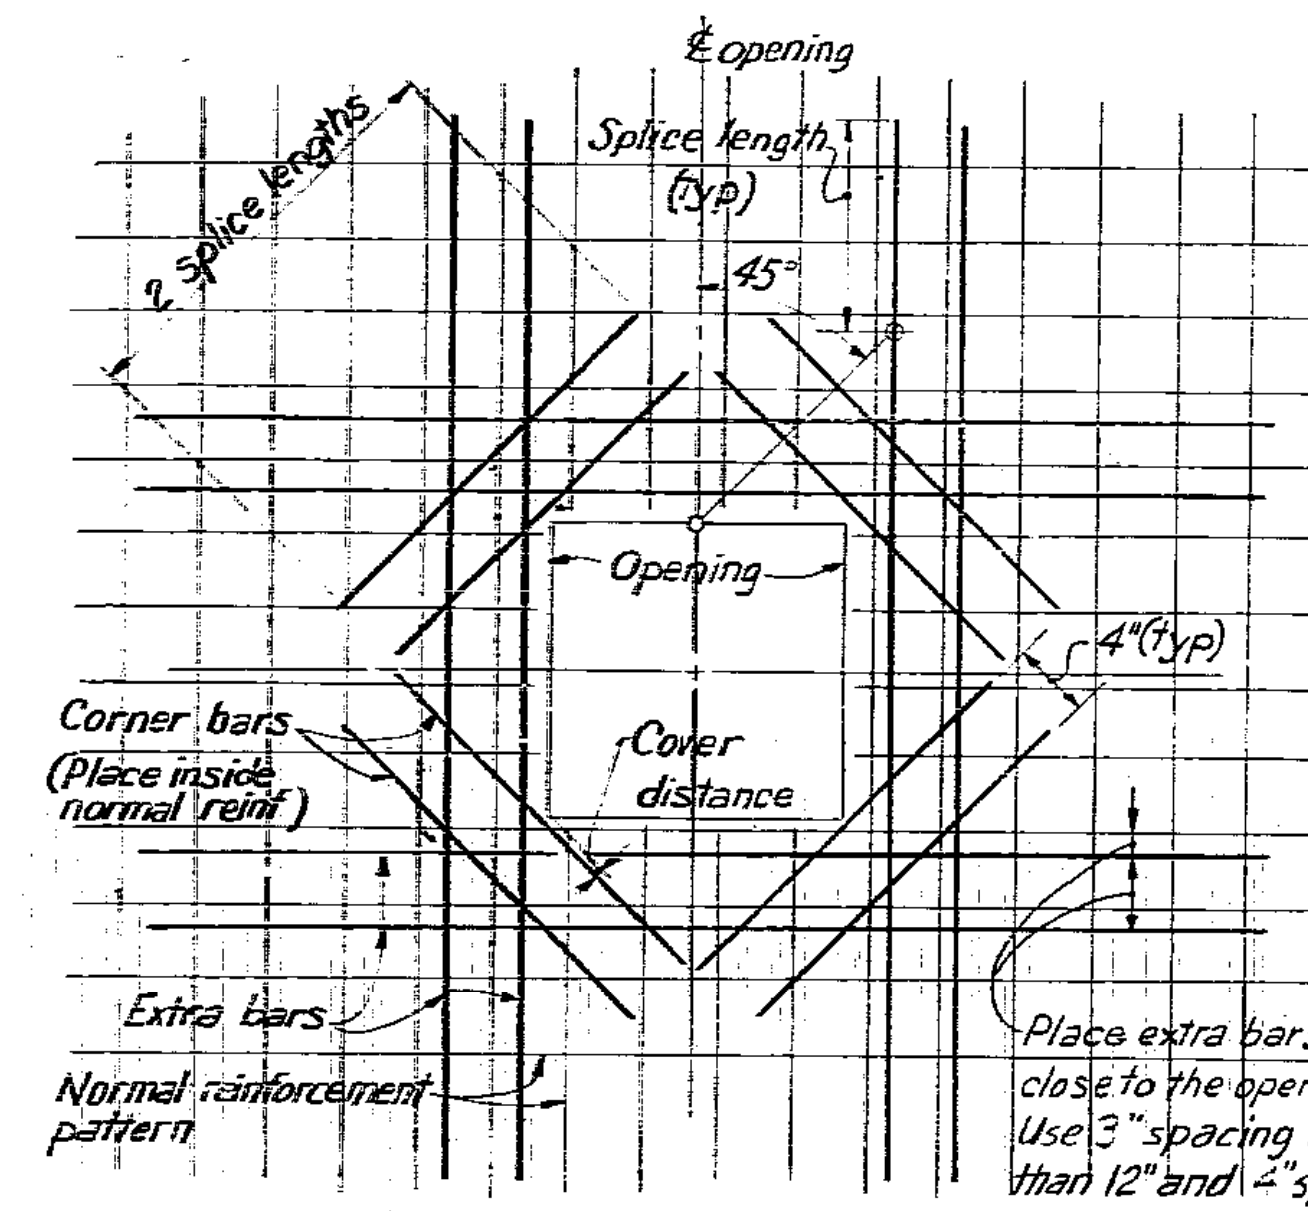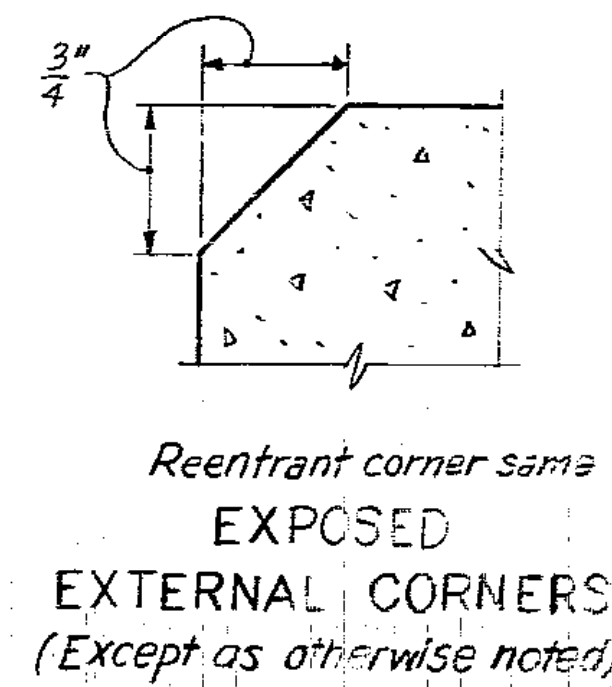

REINFORCEMENT AROUND OPENINGS NOTES:

1. Cross-sectional area of extra bars shall equal or exceed area of normal bars interrupted by opening.
2. Corner bars are same size as extra bars, but not larger than #8.
3. Reinf. shown to be for 4:1, if normal reinf.
4. This standard shall be used for both slabs and walls.
5. Circular openings shall have reinforcement similar to rectangular openings.
6. Wall openings wider than 7'-0" to be reinforced as shown on drawings.
7. Add second corner bar if slab or wall is 12" thick or over.

GENERAL NOTES FOR CONCRETE
Provide tool-edged for all construction and contraction joints on surfaces where wood float or steel trowel finish is required.
Concrete surfaces exposed to the flow of water must be smooth.
Unless otherwise noted, roughen surfaces of pours at construction joints.
Waterstops to be continuous.

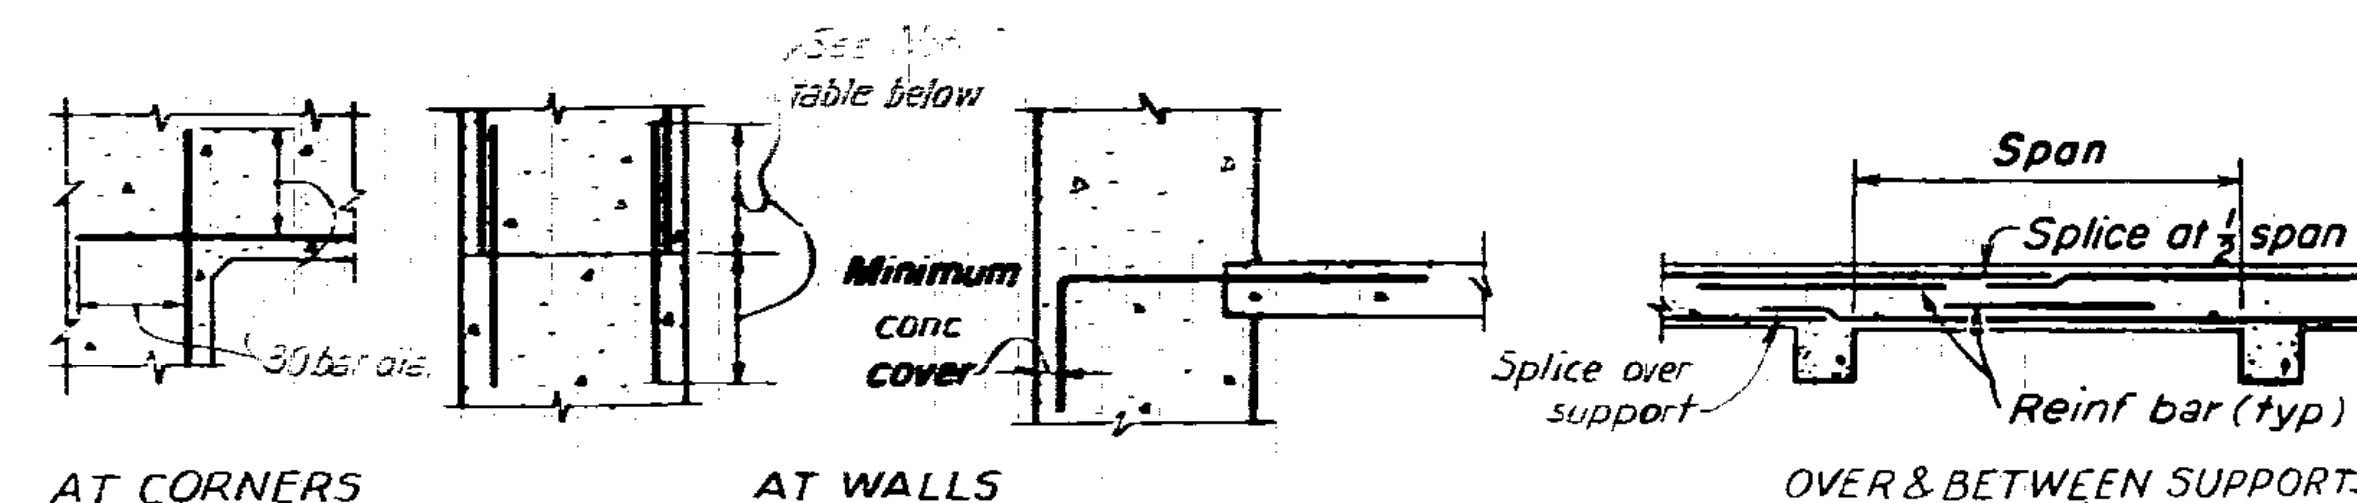

TYPICAL REINFORCEMENT EMBEDMENT, PROJECTION & SPLICE DETAILS
(Unless otherwise noted on drawings)

TYPICAL BAR BILLING
General Billing: *6, 6oc, where bar length and number required is not given the Contractor shall determine same from bar spacing, location and dimensions of structure.
Detailed Billing: 8*10, 4-6; 10*6, 8-0; 6oc, 4ef; 10*11; 6oc, 4f, is used where a definite number of bars or bar length or spacing is required.

- NOTES:**
1. Feet and inch marks are omitted from length and spacing dimensions.
 2. Bar spacing is given in inches.
 3. All bars are billed by size, spacing and in some instances length, in one view only, as shown by "Typical bar billing". Bars are only identified in other views, e.g.: *6; *10, 4-6

STANDARD ABBREVIATIONS FOR REINFORCEMENT



ml = middle layer il = inside layer
ff = far face nf = near face
tf = top face bf = bottom face
el = each layer ef = each face
oc = on center bl = bottom layer
tl = top layer ol = outside layer
ew = each way

PROTECTIVE COVER

Main reinforcement to have concrete cover as follows: (except as otherwise noted on drawings) min max
1. Bottom of foundation and footings 4" 5"
2. Backfilled surfaces, surfaces of water passages 2" 4"
3. Exterior walls, beams and slabs 2" 3"
4. Interior walls, beams and columns 1" 2"
5. Interior slabs 1" 1 1/2"
6. Cover for secondary reinforcement (i.e. stirrups, col ties), may be reduced by the diameter of such bars.

ABBREVIATIONS & SYMBOLS

alt = Alternate	HP = High point	reinf = Reinforcement
Al = Aluminum	ID = Inside diameter	req'd = Required
CJ = Construction joint	jt = Joint	std = Standard
cc = Center to center	L = Length along curve	Sta = Station
cl = Center line	LP = Low point	sym = Symmetrical
cl = Clear	max = Maximum	struct = Structure
cl = Column	min = Minimum	T = Tangent length
conc = Concrete	mfr = Manufacturer	typ = Typical
DA = Dovetail anchors	nts = Not to scale	VG = V-groove
φ = Diameter	No = Number	WL = Working line
dia = Diameter	oc = On center	WP = Working point
dn = Down	OD = Outside diameter	WS = Water stop
dwg = Drawing	PC = Point of curvature	Δ = Intersection angle
EA = Expansion anchors	PI = Point of intersection	
El = Elevation	PT = Point of tangency	
ga = Gage	proj = Projection	
	R = Radius	

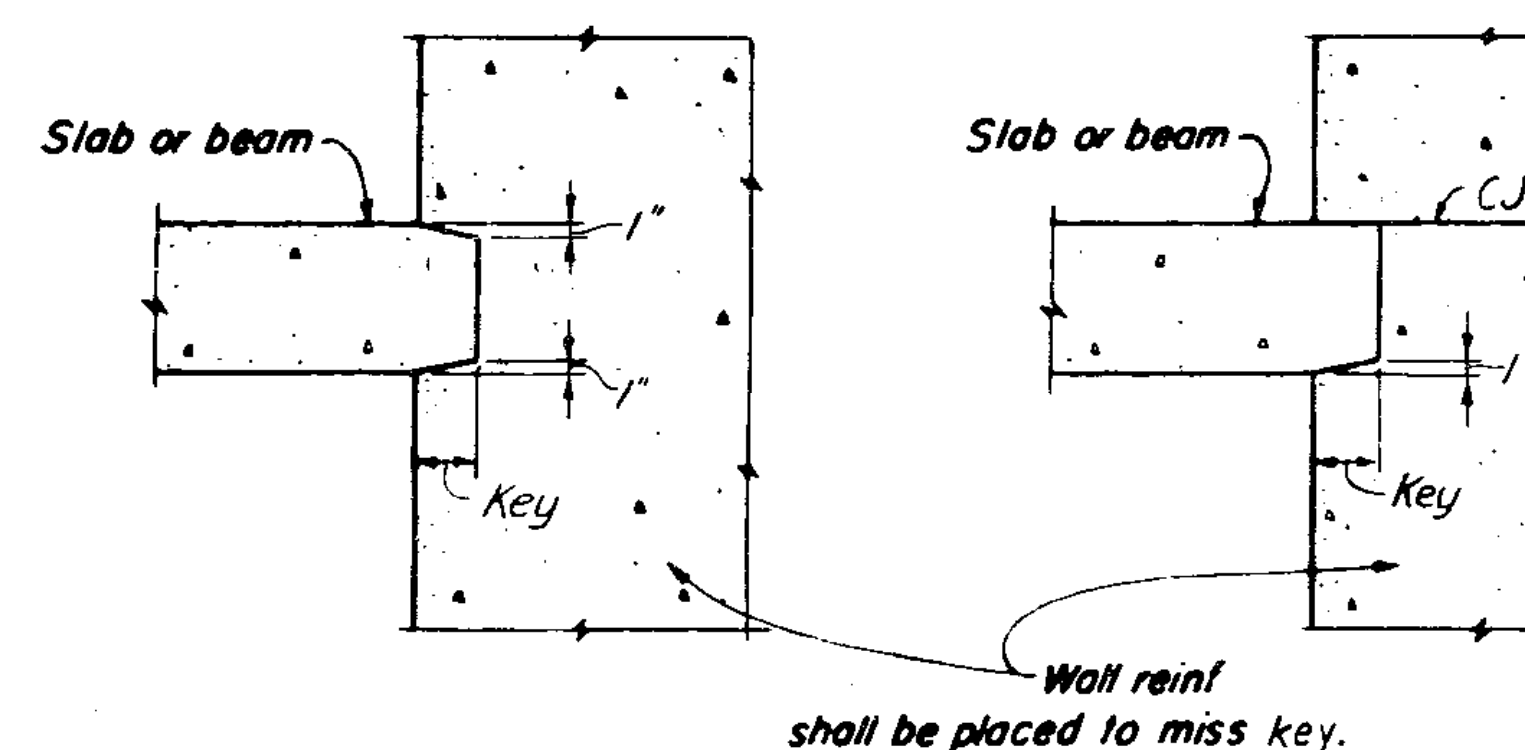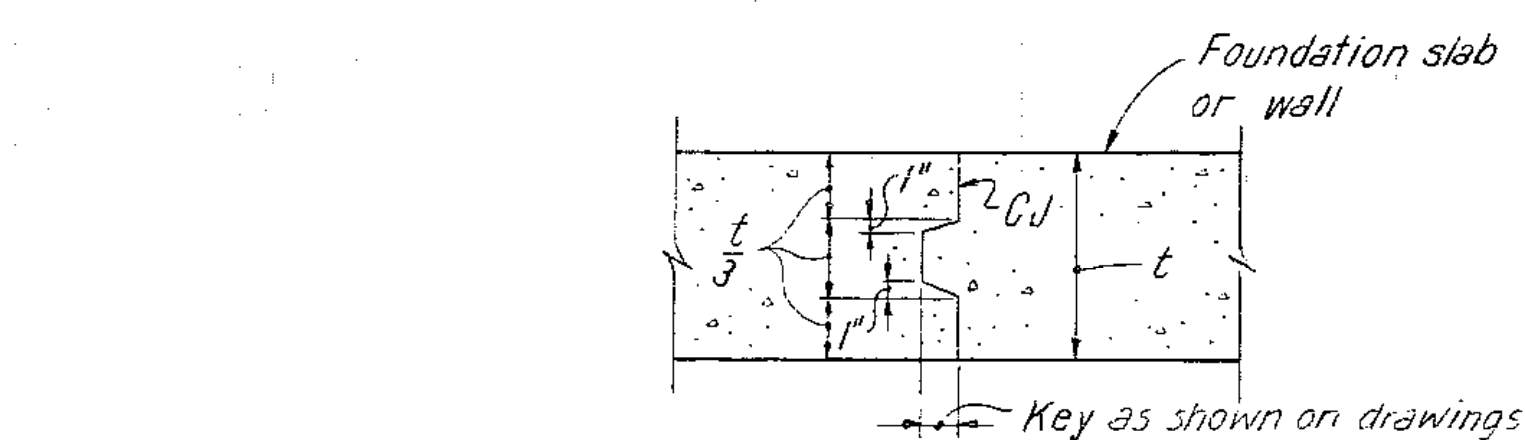


TYPICAL KEY DETAILS

NOTE:
Laps shall be detailed in accordance with table below, unless otherwise noted.
Laps for #8 bars or smaller, spaced less than 12" diameter, must be increased by 20%.



Bar size	Lap length in feet and inches	"Top Bars" "Other Bars"
3	1'-0"	1'-0"
4	1'-0"	1'-0"
5	1'-3"	1'-3"
6	1'-6"	1'-6"
7	2'-4"	1'-9"
8	3'-0"	3'-4"
9	4'-7"	3'-3"
10	5'-9"	4'-1"
11	7'-1"	5'-1"

REINFORCING BAR LAPS


CONSTRUCTION DWG.
AS BUILT

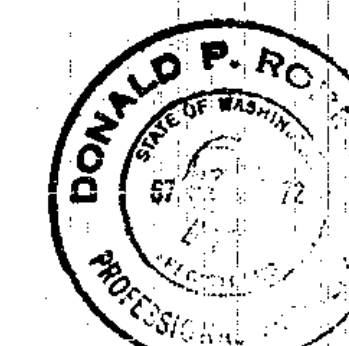

As	No Asbuilt Revisions	W/JW	4/14/67
I	Minor revisions	4/14/67	4/14/67
NO.	REVISION	DATE	DATE
CITY OF TACOMA DEPARTMENT OF PUBLIC UTILITIES MAJOR PROJECTS DIVISION			
MOSSYROCK PROJECT SALMON HATCHERY - BARRIER DAM			
STANDARD DETAILS SHEET 1			
HARZA ENGINEERING COMPANY			
DRAWN	SAIA	DESIGNED	DPB
CHECKED	SWG	REVIEWED	DPB
APPROVED FOR CITY OF TACOMA AS TO GENERAL FEATURES			
TACOMA, WASHINGTON			
SCALE	NONE	DATE	MAY, 1967
DRAWING NUMBER		MA 2775 R1/AS	
DRAWER NO.			

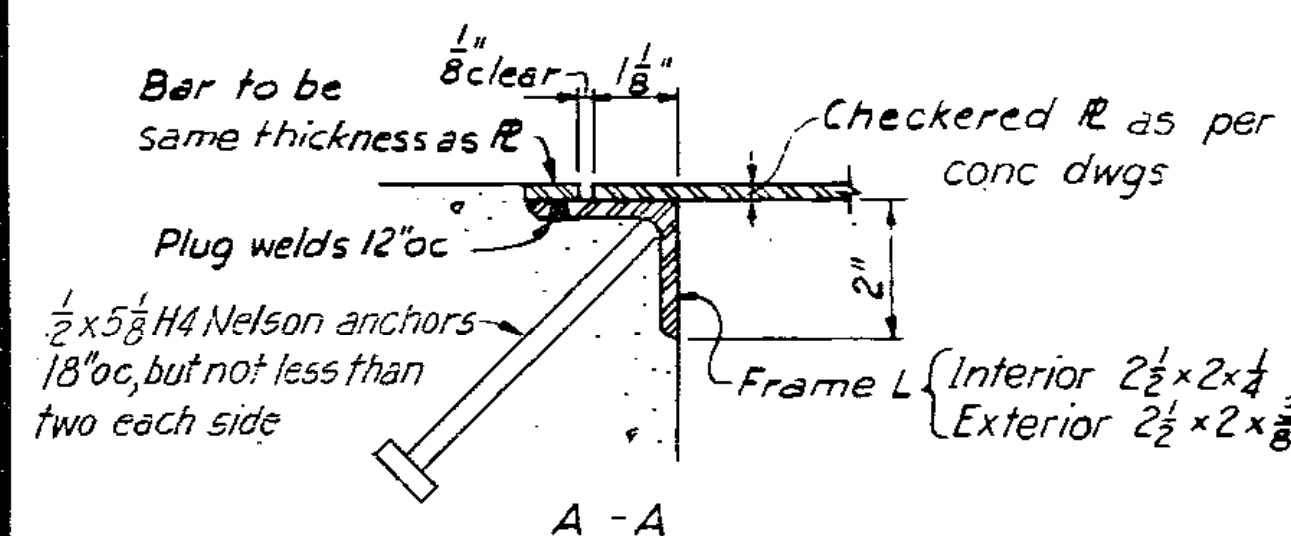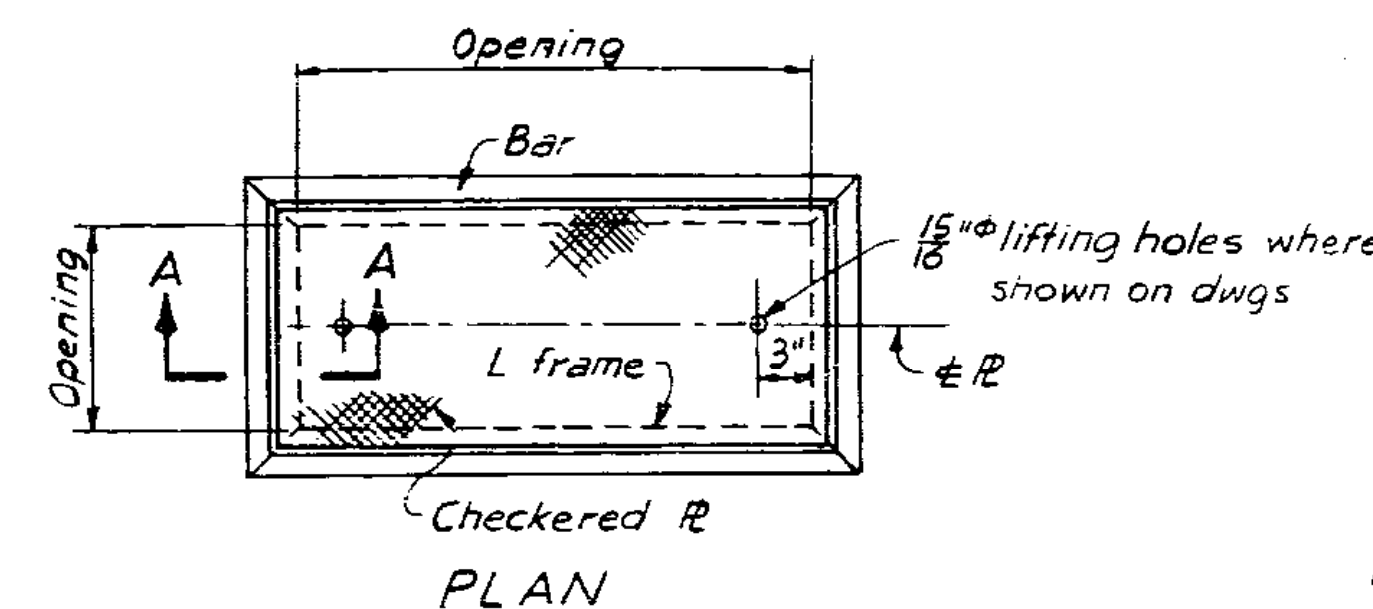


COVER PLATE AND FRAME

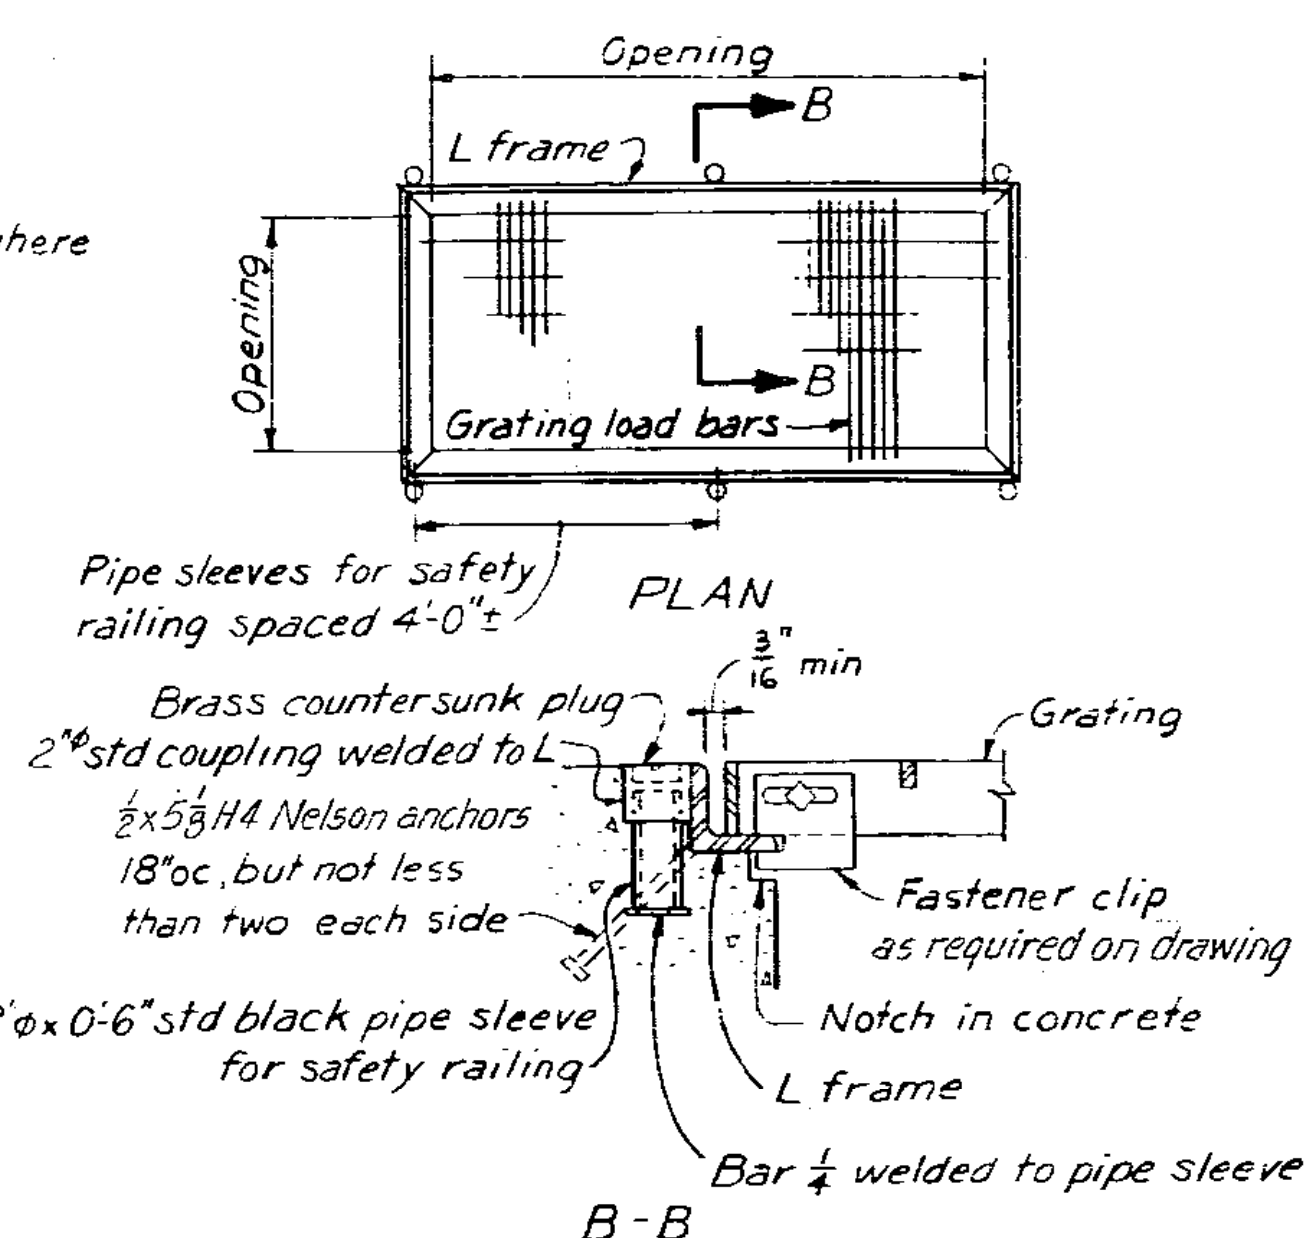


Grating & frame angles as per conc dwgs
Provide safety railing sleeves where shown


GRATING AND FRAME

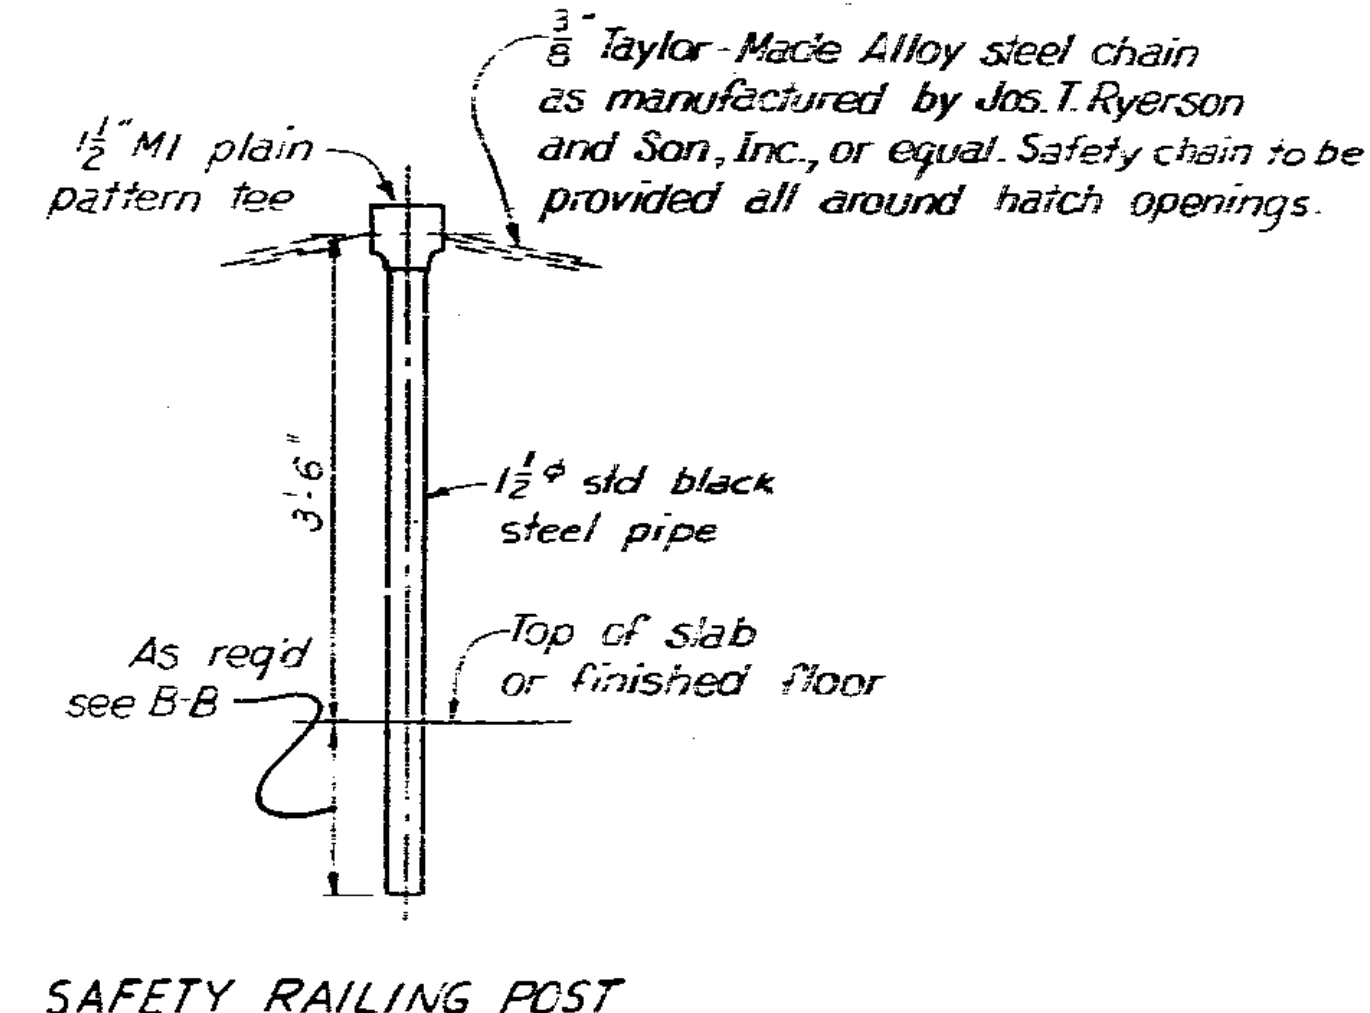


SAFETY RAILING POST

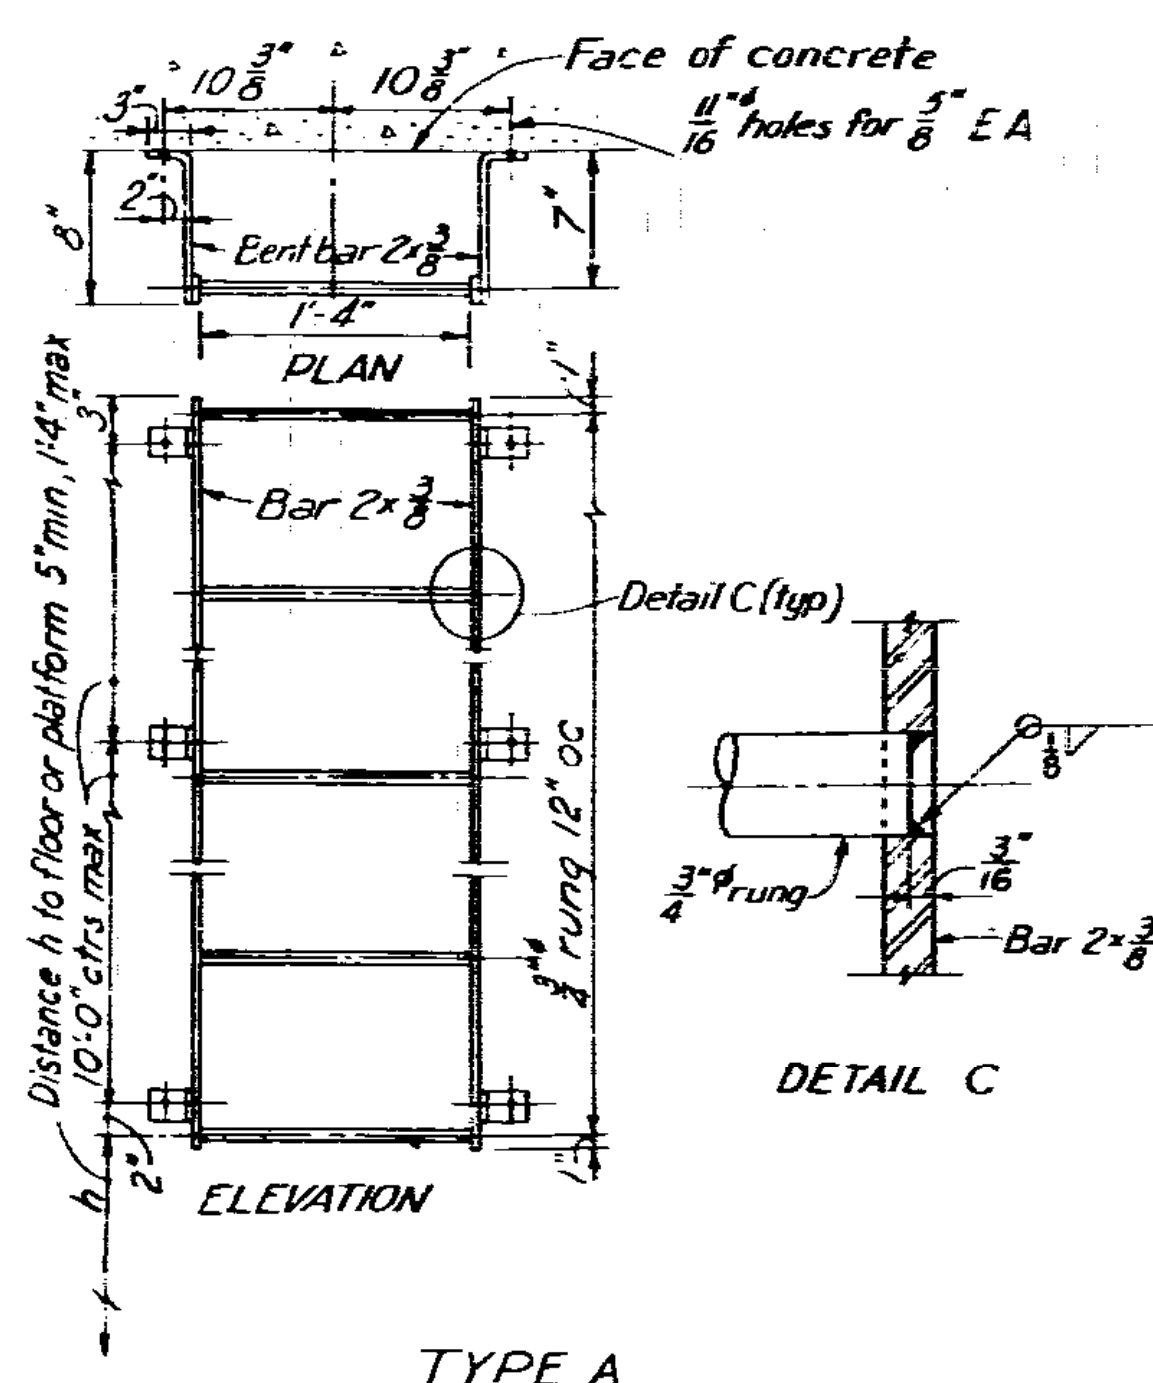


TYPICAL STEEL LADDERS

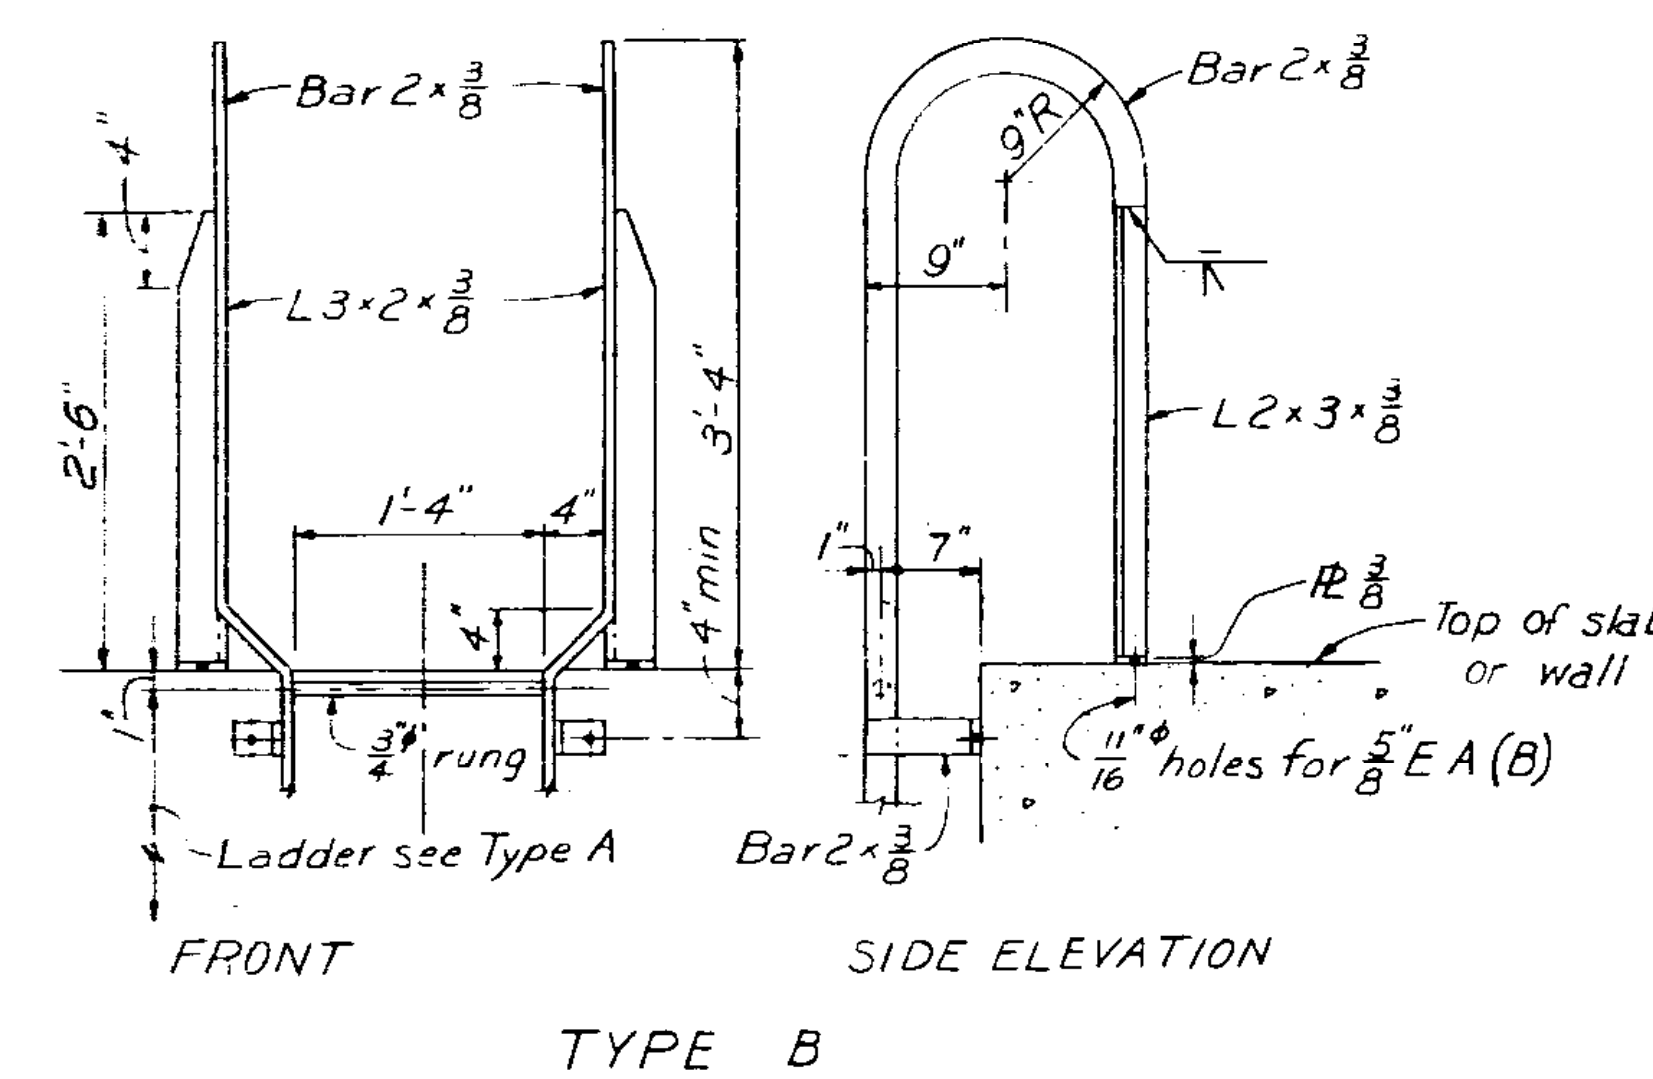



ANCHOR BOLTS

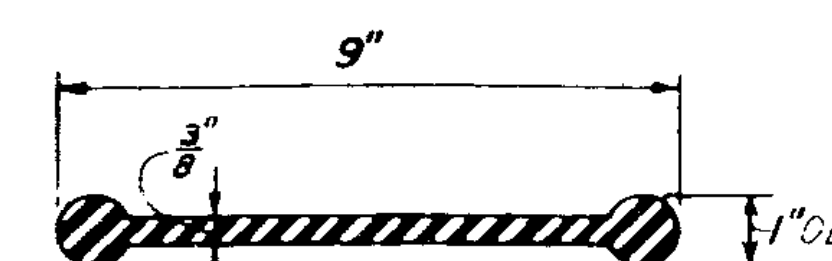

Type A
TWO BULB WATERSTOP

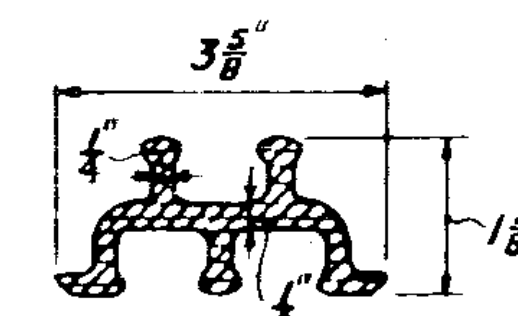


Type B
TWO RIB LABYRINTH
WATERSTOPS

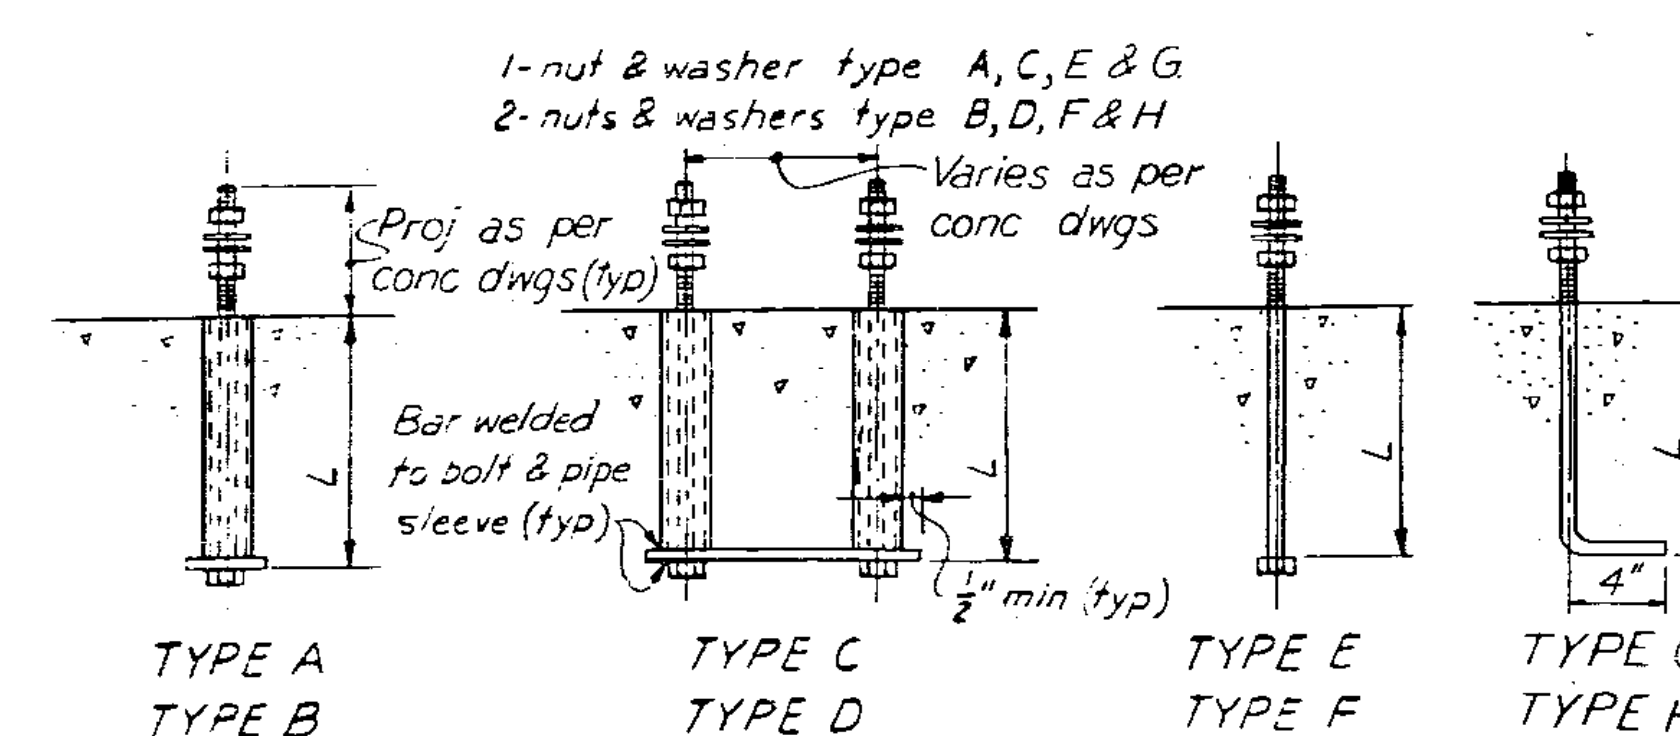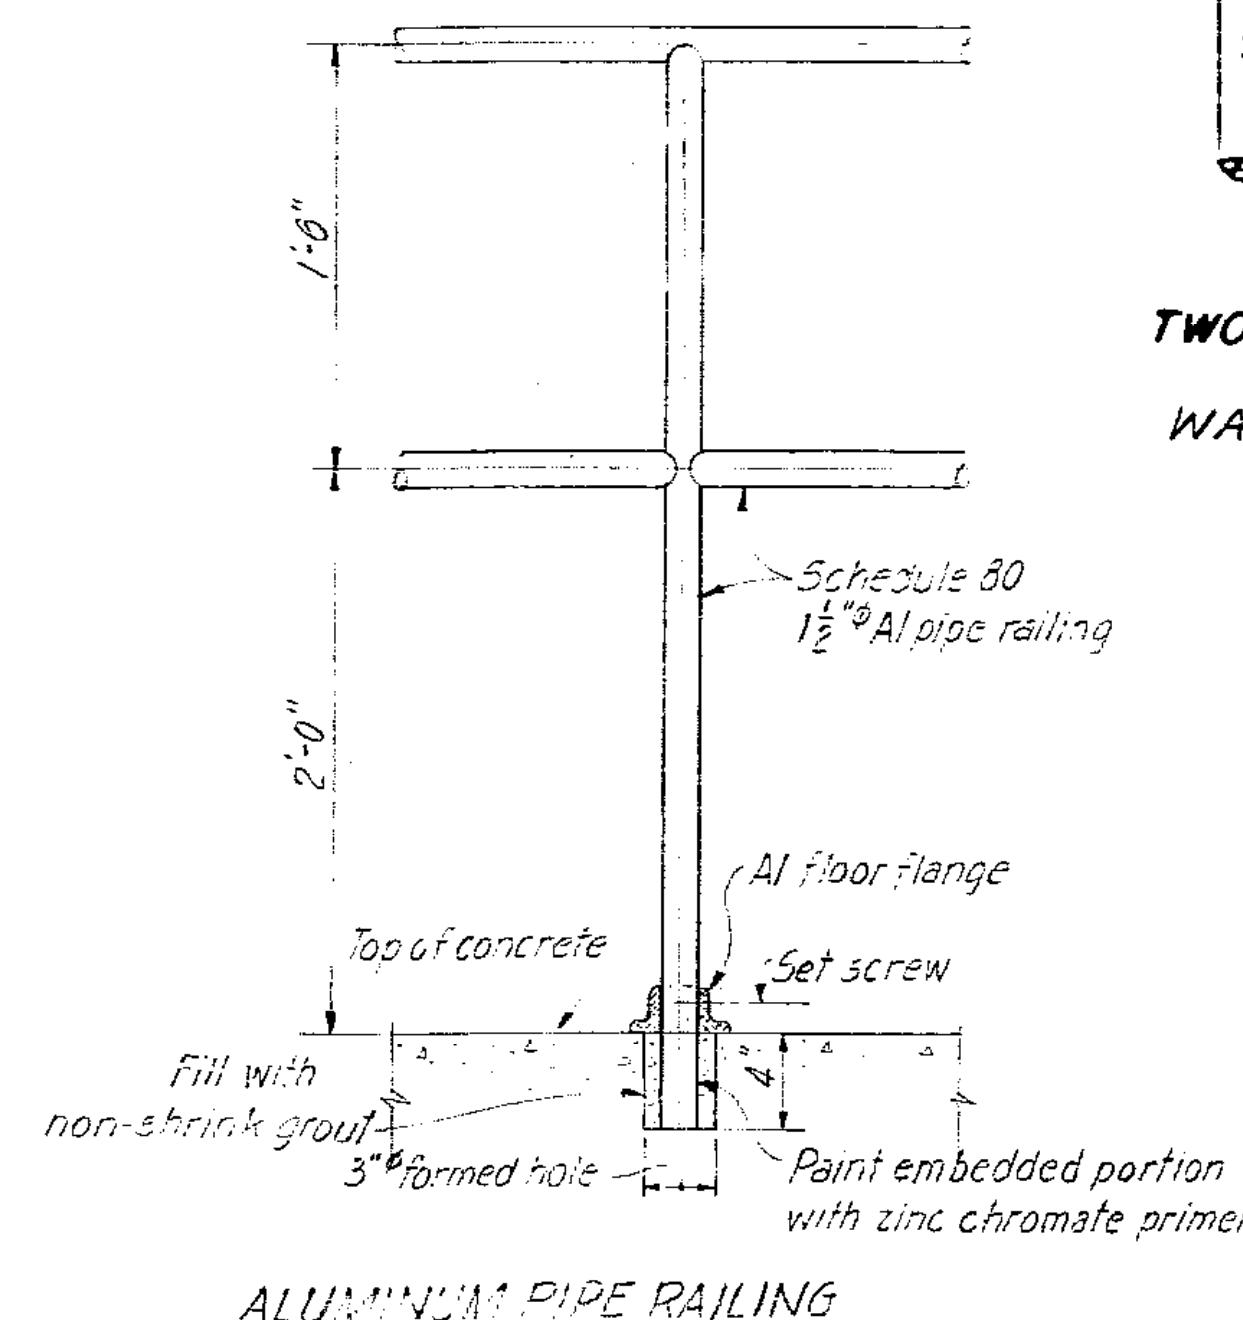

Bolt d.a.	Pipe d.a.	L *	Bar size Type A & B	Bar size Type C & D
1/2	1 1/2	9	2 1/2 x 2 x 0-2 1/2	2 1/2 x 3/4
3/4	1 1/2	1-0"	3 x 2 x 0-3"	3 x 3/4
3/4	2	1-2"	3 1/2 x 2 x 0-3 1/2	3 1/2 x 3/4
1	2	1-4"	4 x 2 x 0-4"	4 x 3/8
1	2	1-6"	4 1/2 x 2 x 0-4 1/2	4 1/2 x 3/8
1 1/2	2	1-8"	5 x 2 x 0-5"	5 x 3/8
1 1/2	2 1/2	2-0"	5 1/2 x 2 x 0-5 1/2	5 1/2 x 3/8
1 1/2	2 1/2	2-3"	6 1/2 x 2 x 0-6 1/2	6 1/2 x 3/8

* Unless otherwise shown on dwgs

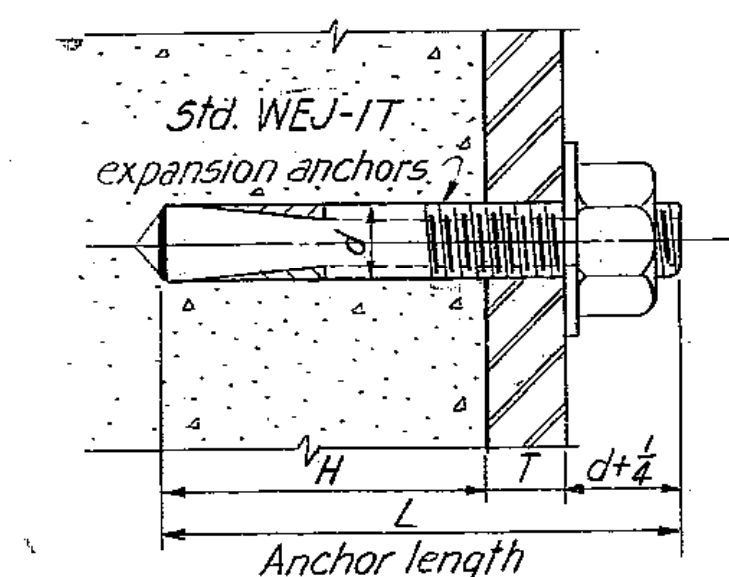

TYPICAL EXPANSION ANCHOR DETAIL

WEJ-IT Dia & hole Dia (d)	Min depth of hole (H)	Available lengths (L)	Min distance between holes	Min edge distance
Inches	Inches	Inches	Inches	Inches
3/8	1	1 1/2, 2, 3	4 1/2	4
3/8	1 1/2	1 1/2, 2, 2 1/2, 3, 3 1/2, 5, 6	4 1/2	4
1/2	1 1/2	2, 2 1/2, 3, 3 1/2, 5, 6, 7	5	4
1/2	2	3 1/2, 4, 5, 5 1/2, 6, 7	5	4
3/4	3	4, 5, 6, 7, 10	5 1/2	4

EXPANSION ANCHOR INSTALLATION DATA

Reference: WEJ-IT Catalog CF1064
by WEJ-IT EXPANSION PRODUCTS, INC.
Industrial Park/Broomfield, Colorado 80020


NOTES:


Unless otherwise shown or noted:

1. Material to be welded structural steel
2. All steel to be painted.
3. For painting and galvanizing see specifications.
4. Do not paint surfaces embedded in concrete.
5. All gratings to be galvanized after fabrication.
6. All gratings to be furnished in 6'0" sections, except as noted.
7. All sheared edges to be ground smooth.
8. Exposed welds in hatch frame covers etc. to be ground smooth.
9. Catalog numbers and trade names indicate examples of commercial product only. Other manufacturers products approved equal may be substituted.
10. #5 reinf bar with std. hook to substitute for Nelson studs if desired.
11. Reinf. bars in note 11, to have 1/8" fillet weld all around.
12. All welds shall be 1/8" continuous fillet welds.
13. All corners of frames shall be mitered and welded in accordance with approved shop practice. Grind welds smooth on bearing and exposed surfaces.
14. Furnish all expansion anchors and connection bolts where such are required. Diameter of anchors and bolts shall be 1/8" smaller than holes indicated, except where noted.
15. MISCELLANEOUS DETAILS SHOWN ON THIS DRAWING ARE TYPICAL. INFORMATION NOT SHOWN HERE AND/OR NUMBER OF ITEMS REQUIRED SHALL BE IN ACCORDANCE WITH CONCRETE DRAWINGS.
16. The identification symbols (P) for pipe and fittings and (M) for miscellaneous items shown on the drawings correspond to the material identification symbols listed in the specifications.

As	As built, deleted reference to C-C	W/JM	1/4/68
NO.	REVISION	DATE	BY
CITY OF TACOMA DEPARTMENT OF PUBLIC UTILITIES MAJOR PROJECTS DIVISION			
MOSSY ROCK PROJECT SALMON HATCHERY - BARRIER DAM			
STANDARD DETAILS SHEET 2			
HARZA ENGINEERING COMPANY			
DRAWN:	SAIA	DESIGNED:	PPR
CHECKED:	PPR	REVIEWED:	PPR
APPROVED FOR CITY OF TACOMA AS TO GENERAL FEATURES:			
PROJECT MANAGER			
TACOMA, WASHINGTON		DRAWING NUMBER	
DATE		MA 2776 AS	
SCALE	NONE		

CONSTRUCTION DWG
AS BUILT

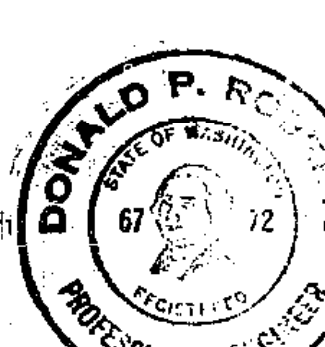

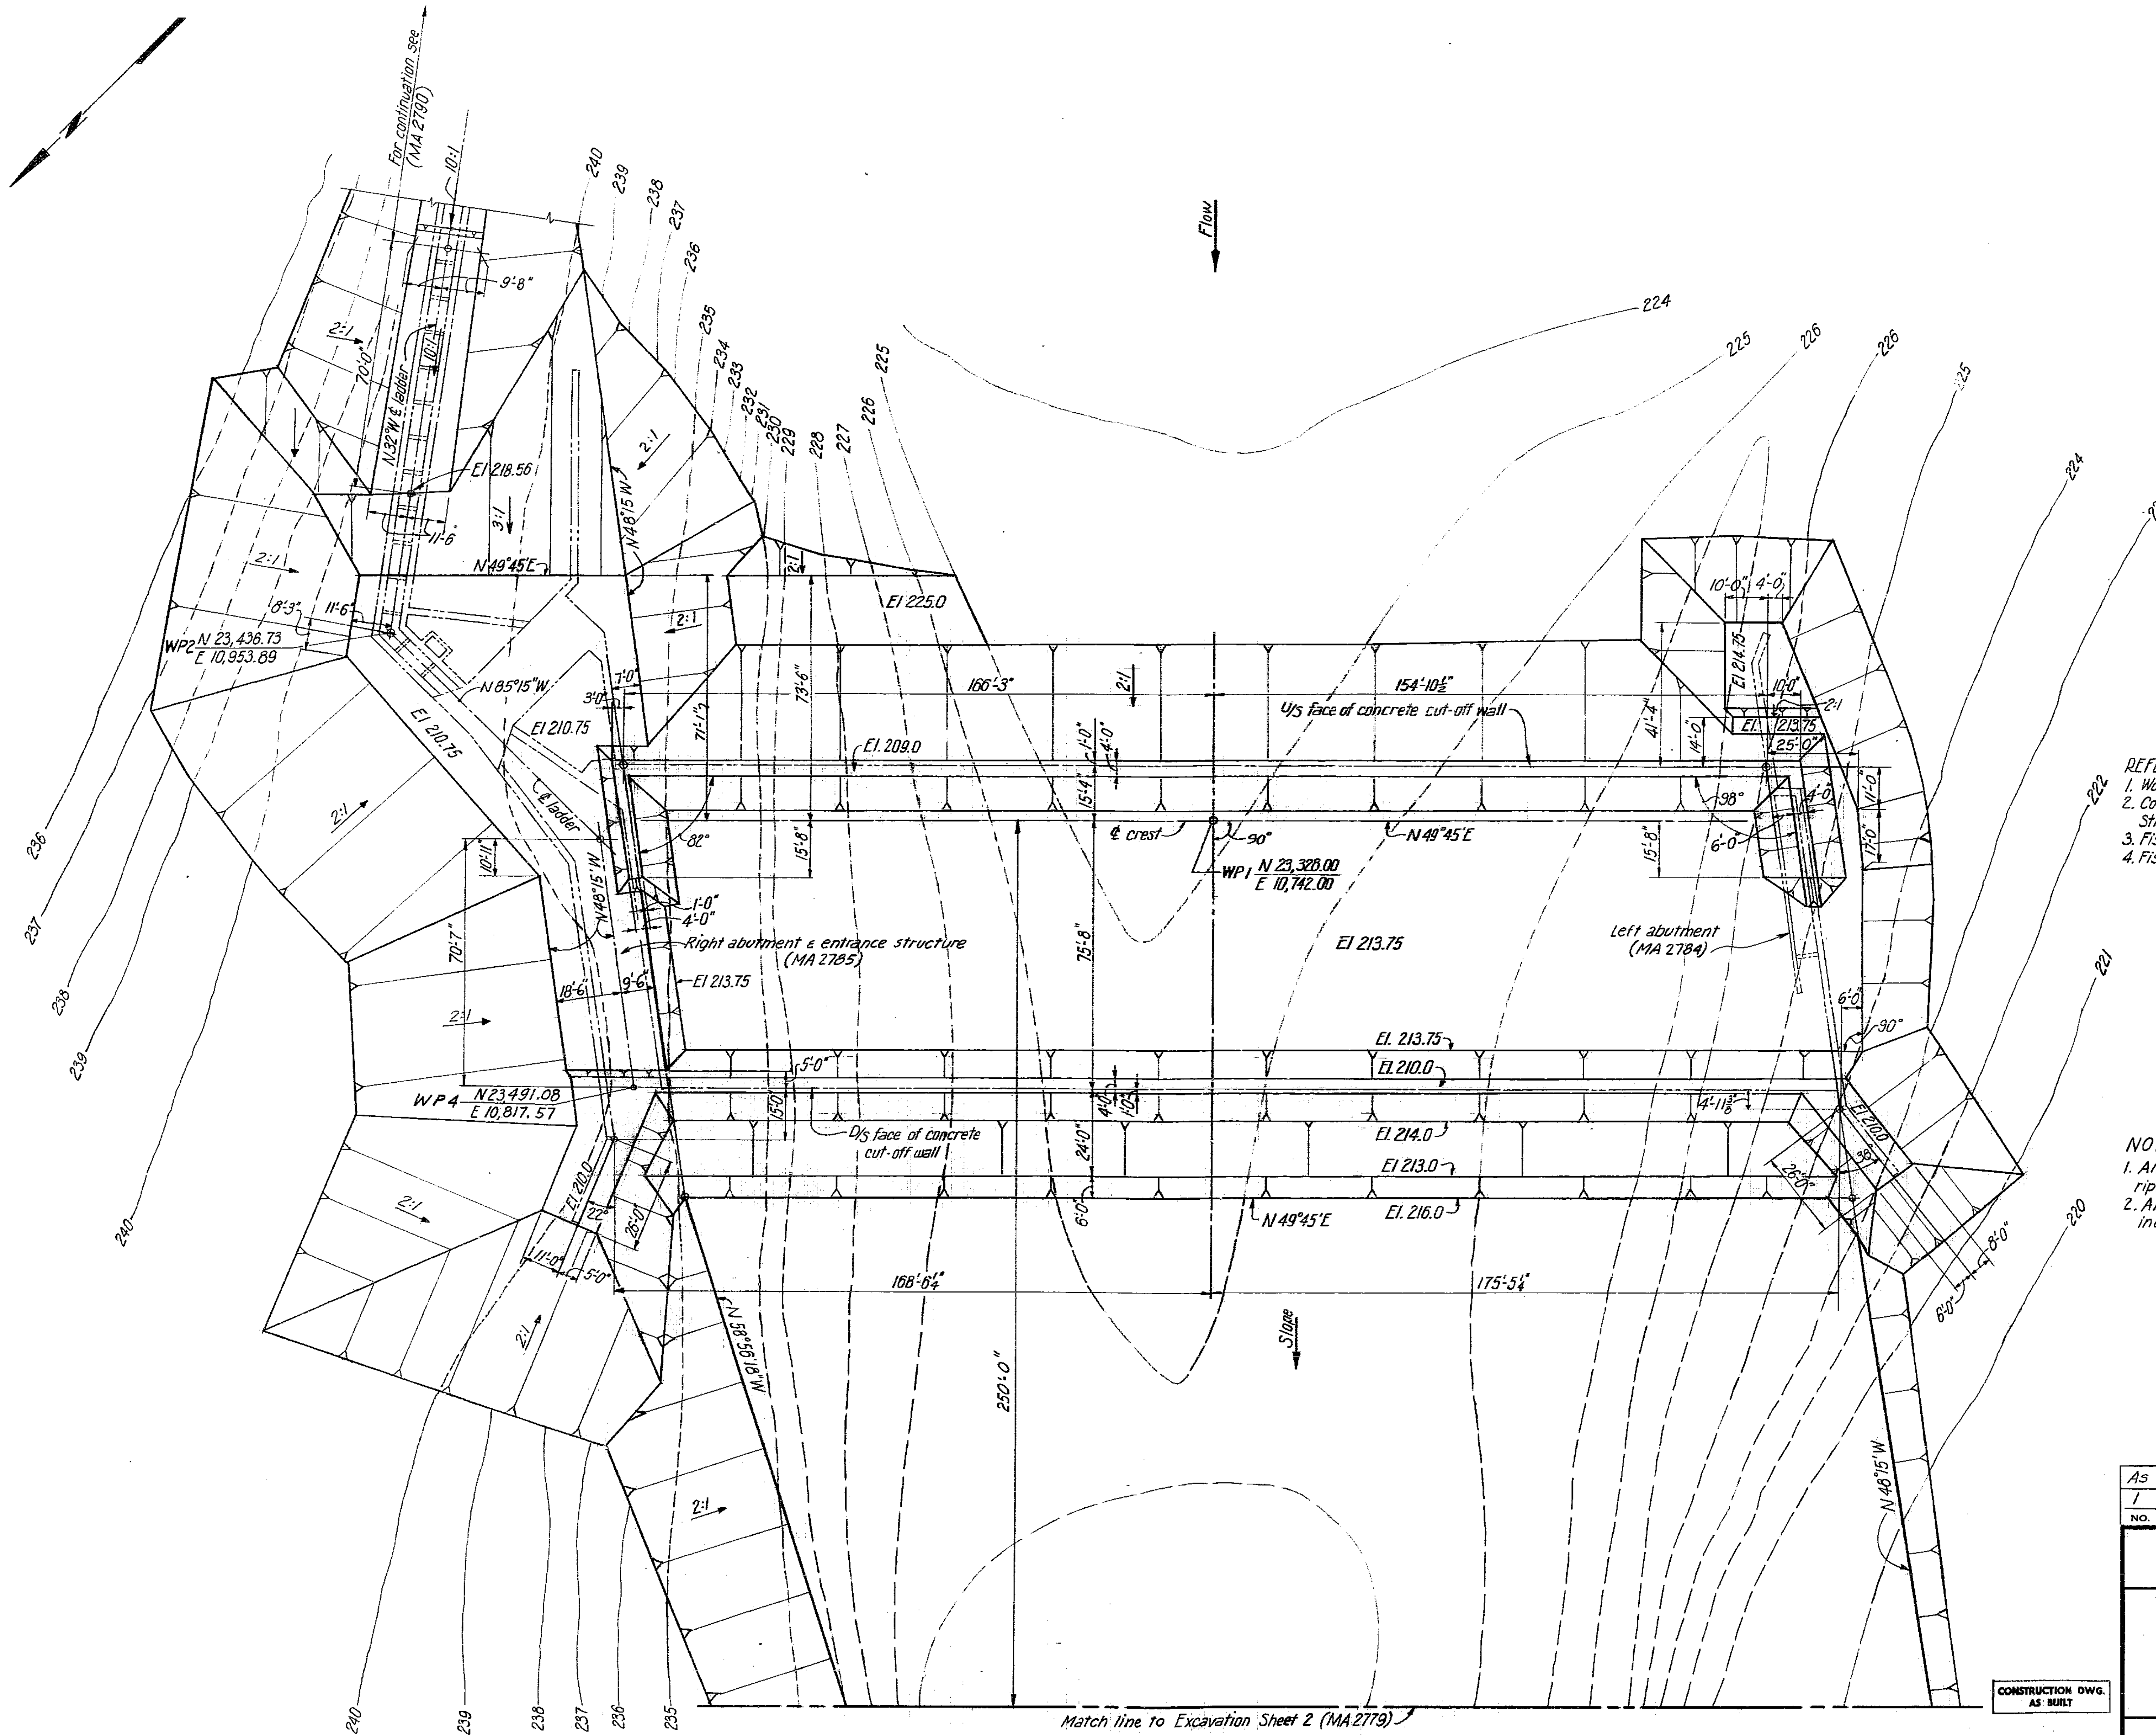

- REFERENCE DRAWINGS:
1. Work this drawing with Excavation Sheet 2 MA2779
 2. Concrete - General Plan - Fish Barrier, Abutments, & Entrance Structures, MA 2782
 3. Fish Ladder - Concrete & Reinf Sheet 1, MA 2789
 4. Fish Ladder - Concrete & Reinf Sheet 2, MA 2790

- NOTES:
1. All final exposed excavation slopes with or without riprap protection shall be 2h:1v except as shown.
 2. All temporary excavation slopes which are not indicated shall be stable slopes.


Scale 0 20 40 Feet
1"=20'-0"

As	As built; note 3 deleted, slopes & elev's	W/JW	4/4/67
1	Revised bearing	4/4/67	4/4/67
NO.	REVISION	BY	APP'D DATE

CITY OF TACOMA
DEPARTMENT OF PUBLIC UTILITIES
MAJOR PROJECTS DIVISION
MOSSY ROCK PROJECT
SALMON HATCHERY - BARRIER DAM
EXCAVATION - SHEET 1


HARZA ENGINEERING COMPANY

DRAWN <i>SM</i>	SWG / SAIA	DESIGNED	<i>DPP Roberts</i>
CHECKED <i>SWG</i>	<i>RS-12</i>	REVIEWED	HARZA ENGINEERING COMPANY
APPROVED FOR CITY OF TACOMA AS TO GENERAL FEATURES			
TACOMA, WASHINGTON		PROJECT MANAGER	
SCALE 1"=20'	DATE MAY, 1967	MA2778 RI/AS	




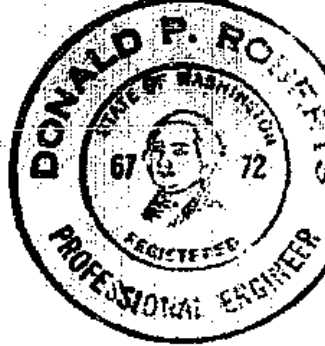


PLAN

Match line to Excavation Sheet 2 (MA2779)

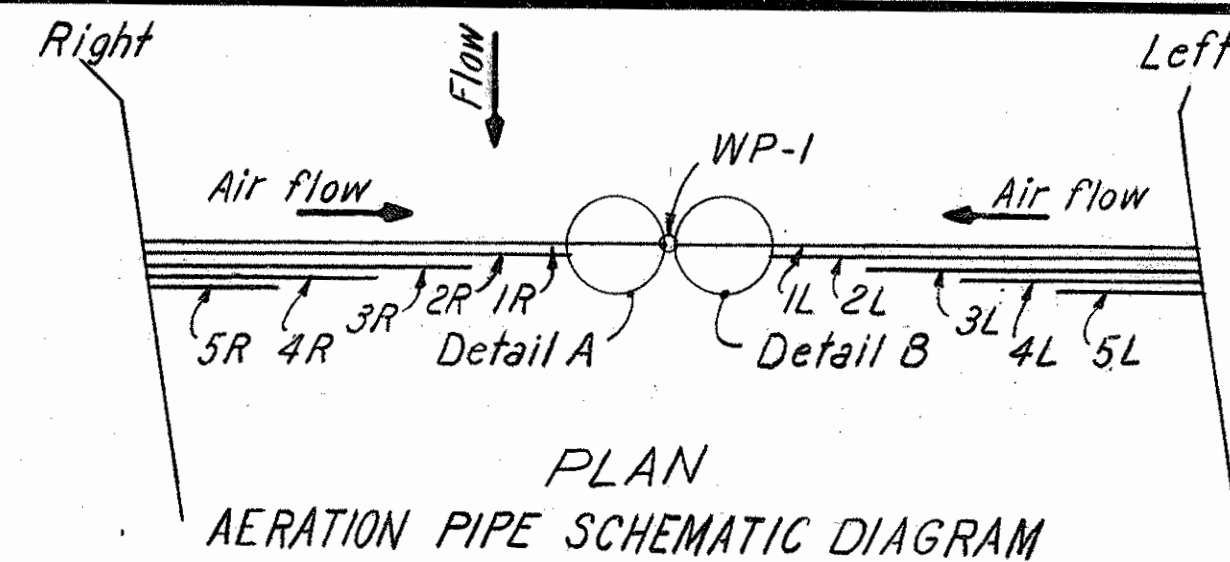


AERATION PIPE SYSTEM		DIMENSIONS						
PIPE NO.		a	b	c	d	e	f	g
1L, 1R, 2L, 2R		1'-6"	3'-6"	4'-6"	5'-0"	6'-0"	6'-0"	3'-6"
3L, 3R, 4L, 4R		2'-0"	4'-0"	6'-0"	6'-6"	7'-6"	0	4'-0"
5L	Varies	6'-0"	7'-0"	8'-0"	8'-6"	0	0	4'-6"
5R	Varies	7'-0"	8'-6"	9'-6"	10'-6"	0	0	5'-6"

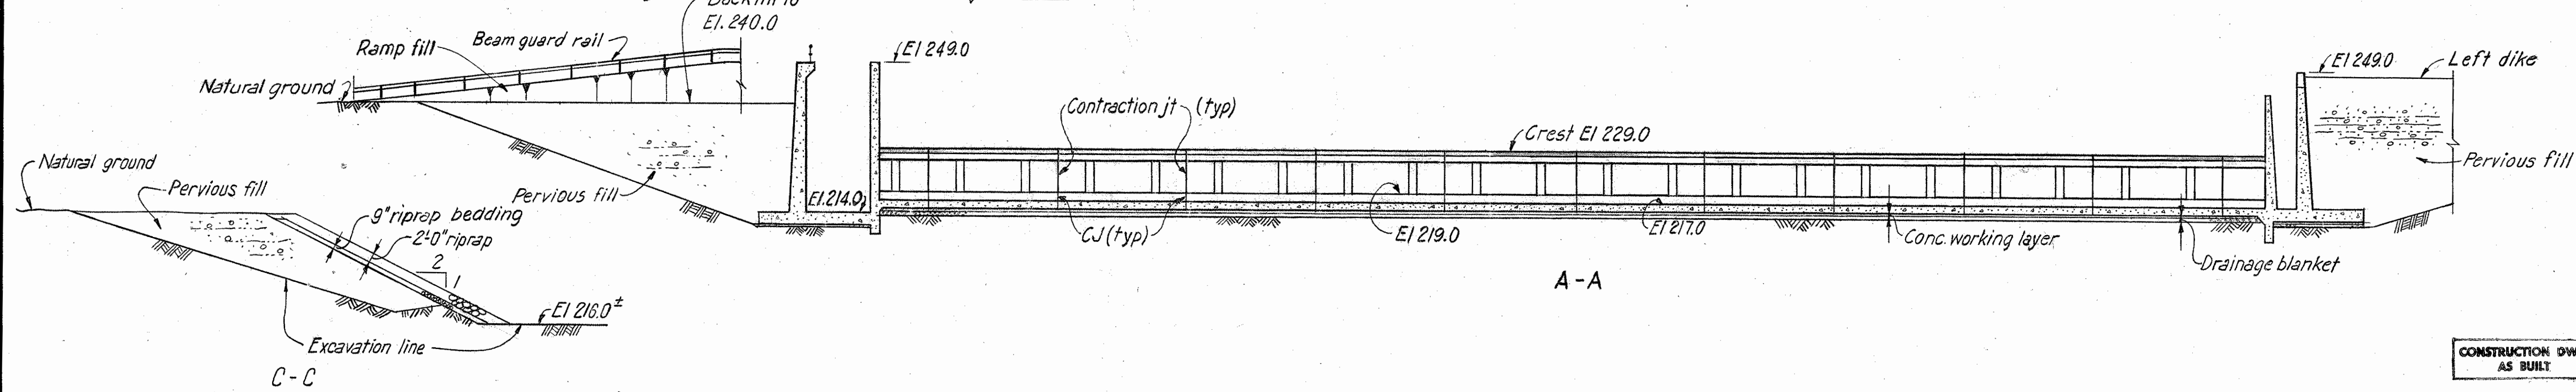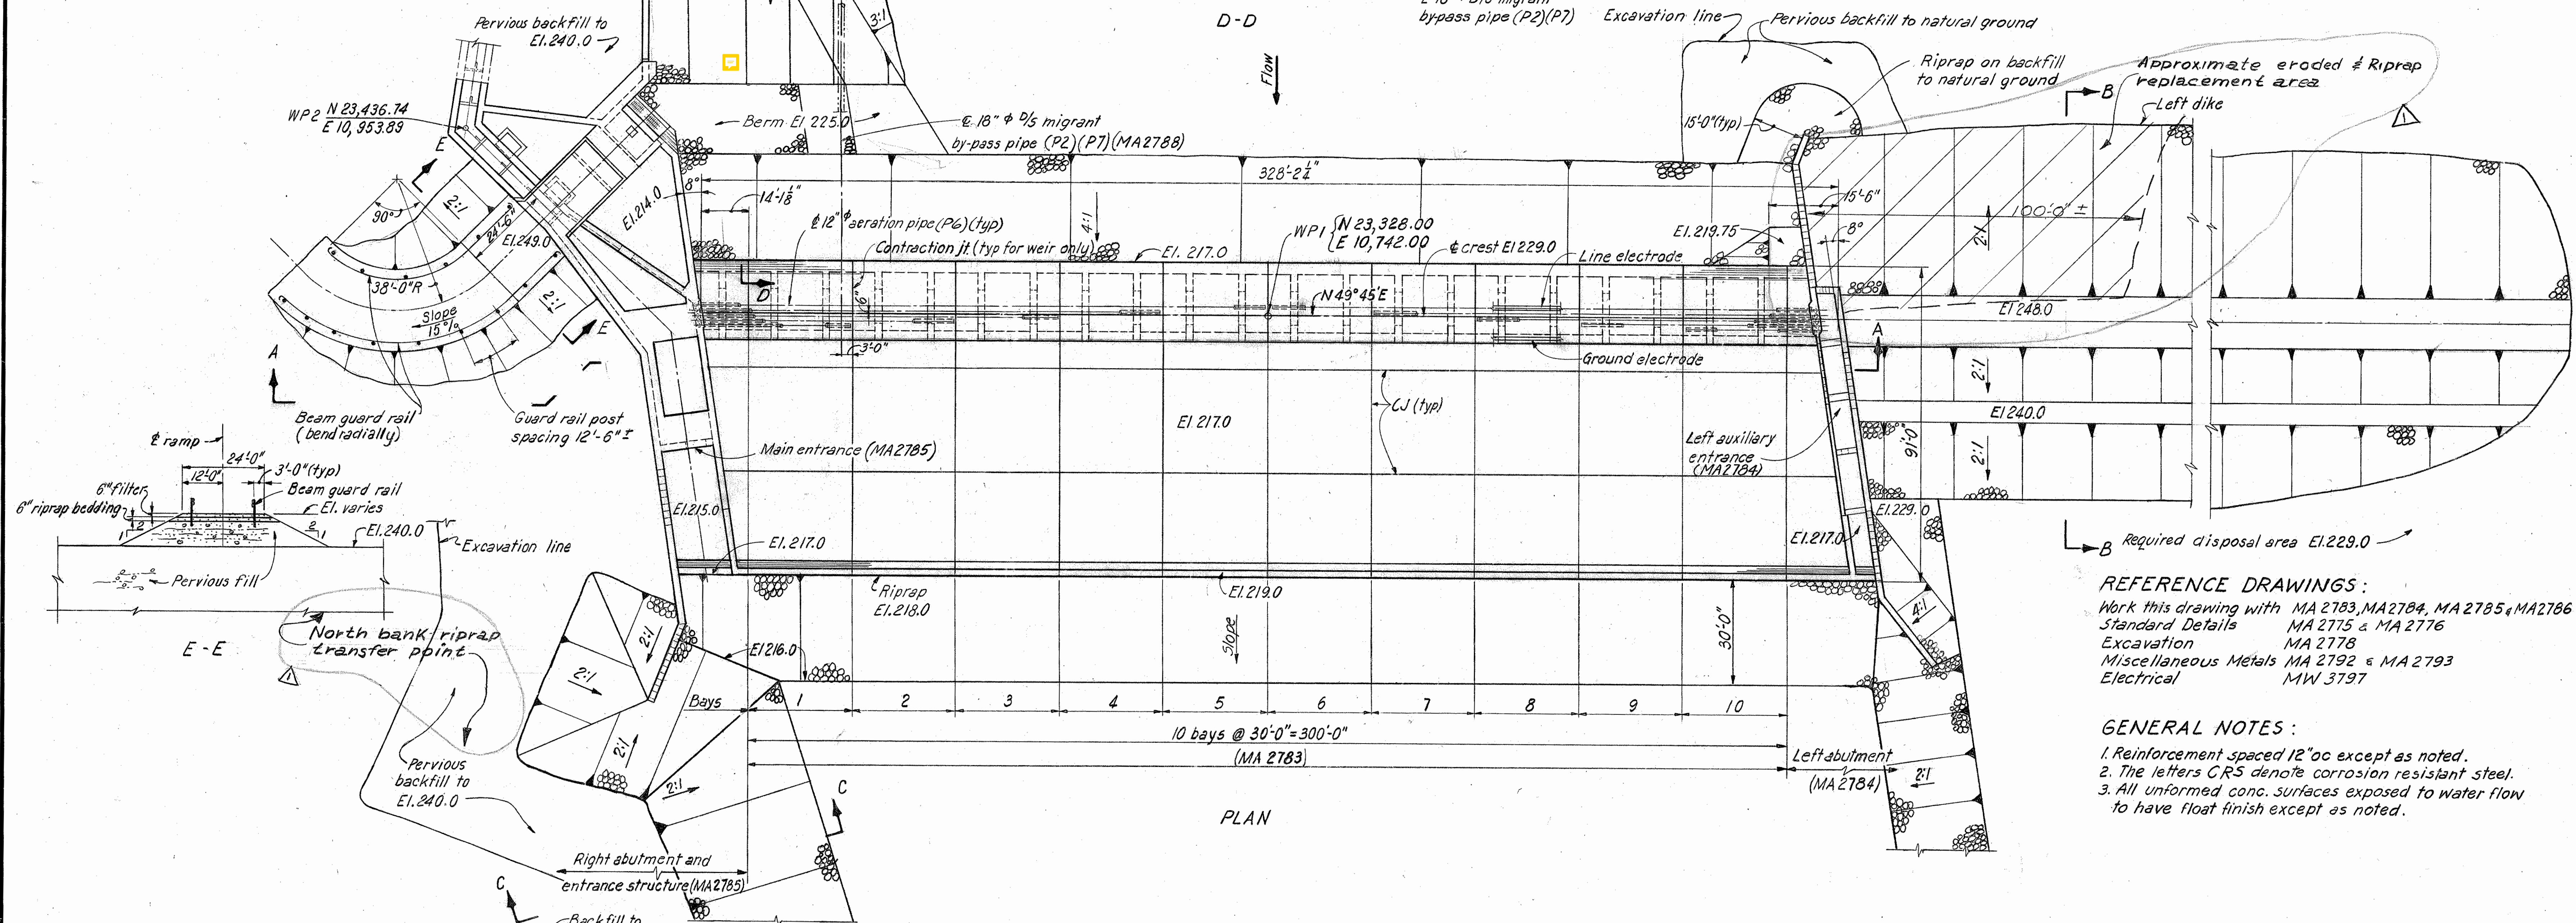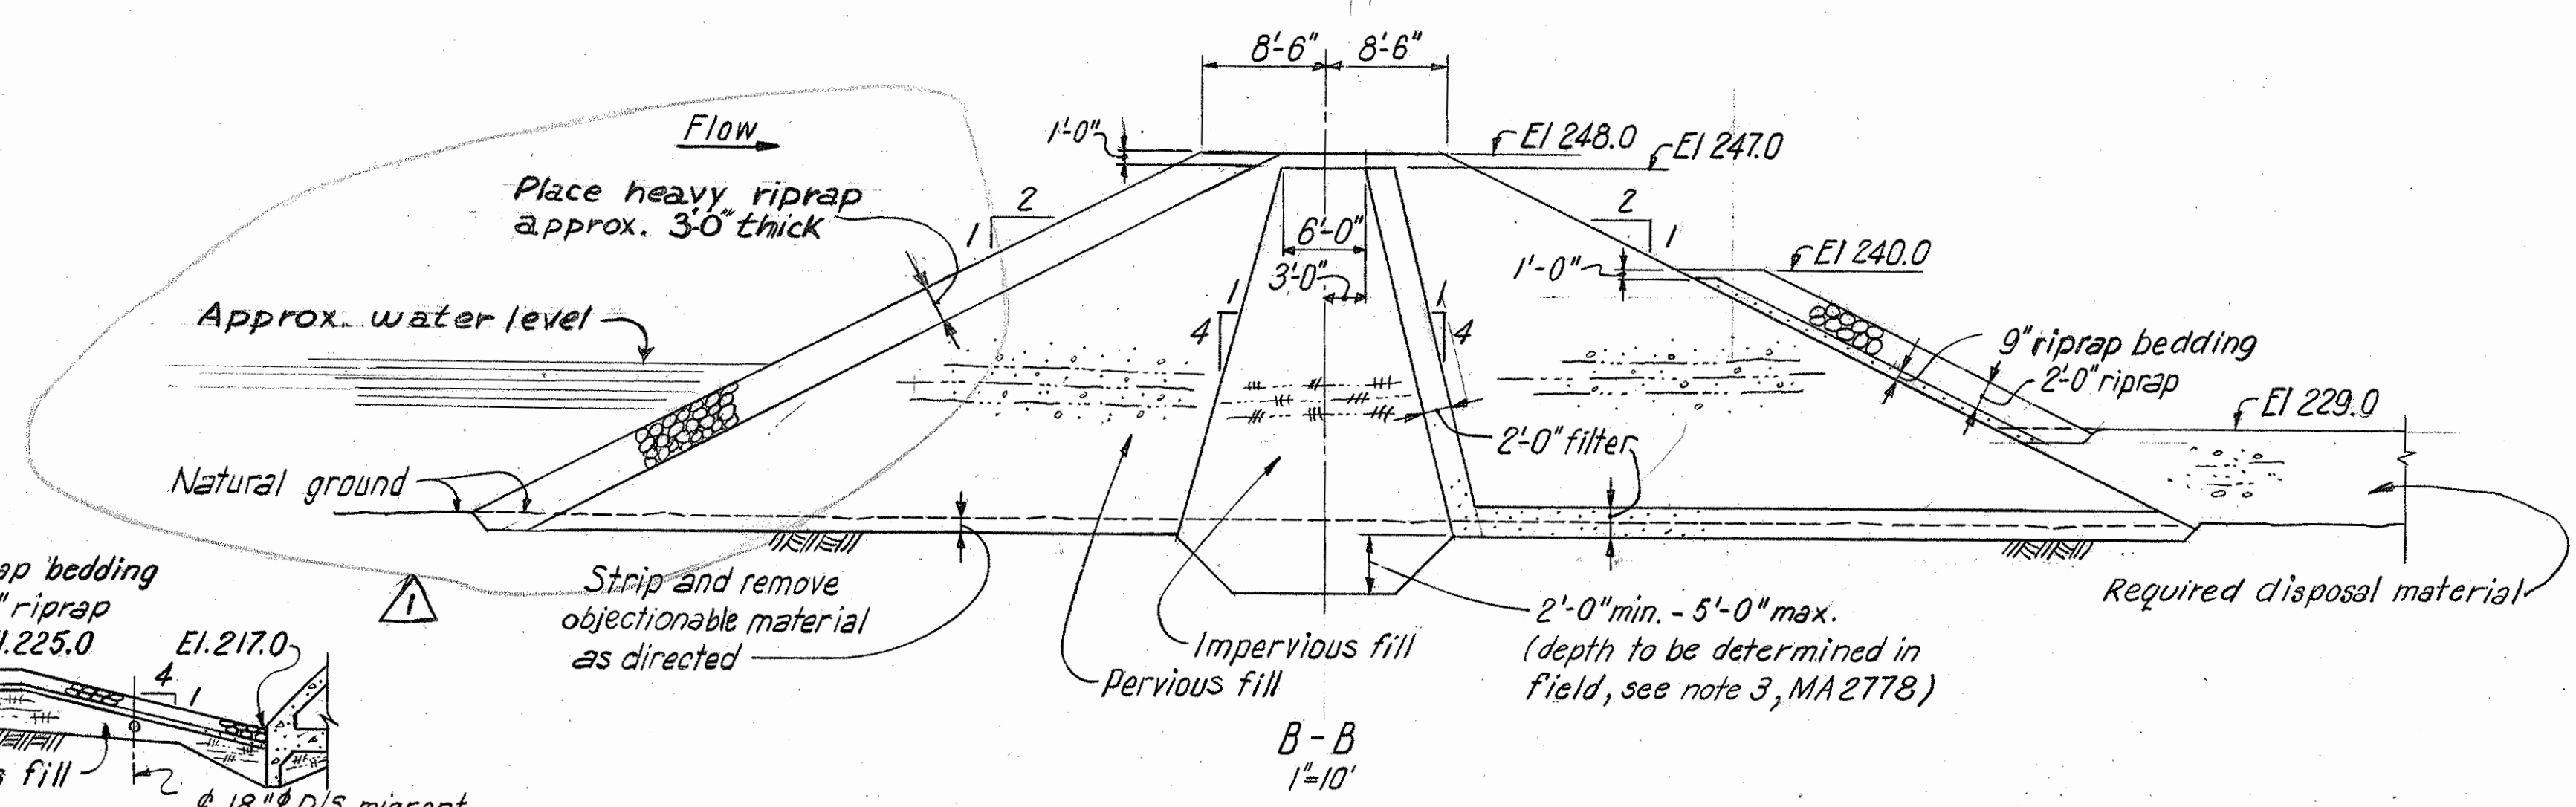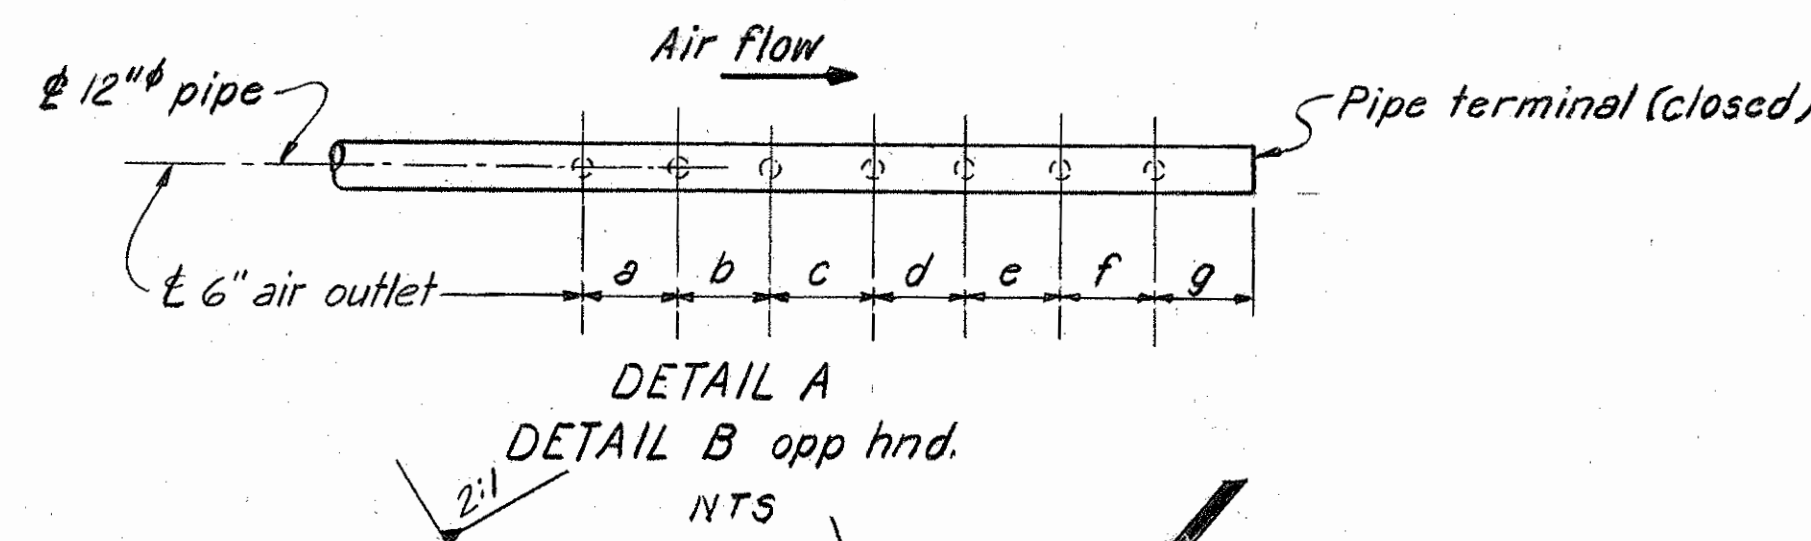



















REFERENCE DRAWINGS:
 Work this drawing with MA 2783, MA 2784, MA 2785, MA 2786
 Standard Details MA 2775 & MA 2776
 Excavation MA 2778
 Miscellaneous Metals MA 2792 & MA 2793
 Electrical MW 3797

GENERAL NOTES:
 1. Reinforcement spaced 12" oc except as noted.
 2. The letters CRS denote corrosion resistant steel.
 3. All unformed conc. surfaces exposed to water flow to have float finish except as noted.

1975 Flood damage repair		7-1977	DGC		
As Asbuilt; minor revisions			HUN	4/1/80	
NO.	REVISION	DATE	BY	APP'D	DATE
CITY OF TACOMA DEPARTMENT OF PUBLIC UTILITIES MAJOR PROJECTS DIVISION					
MOSSYROCK PROJECT SALMON HATCHERY - BARRIER DAM GENERAL PLAN FISH BARRIER, ABUTMENTS, AND ENTRANCE STRUCTURES					
HARZA ENGINEERING COMPANY					
DRAWN: ELM/RLV		FVD / SAIA		DESIGNED: DMR	
CHECKED: FVD		REVIEWED: DMR		HARZA ENGINEERING COMPANY	
APPROVED FOR CITY OF TACOMA AS TO GENERAL FEATURES					
TACOMA, WASHINGTON			DRAWING NUMBER		
DATE MAY, 1967			MA2782 AS		
SCALE As noted					

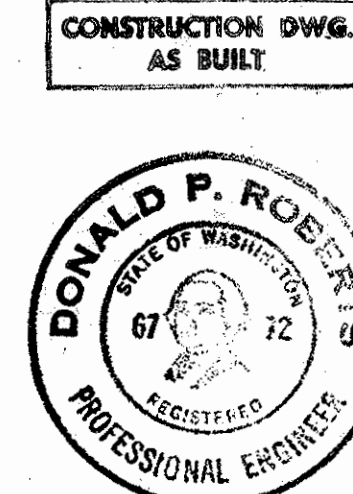

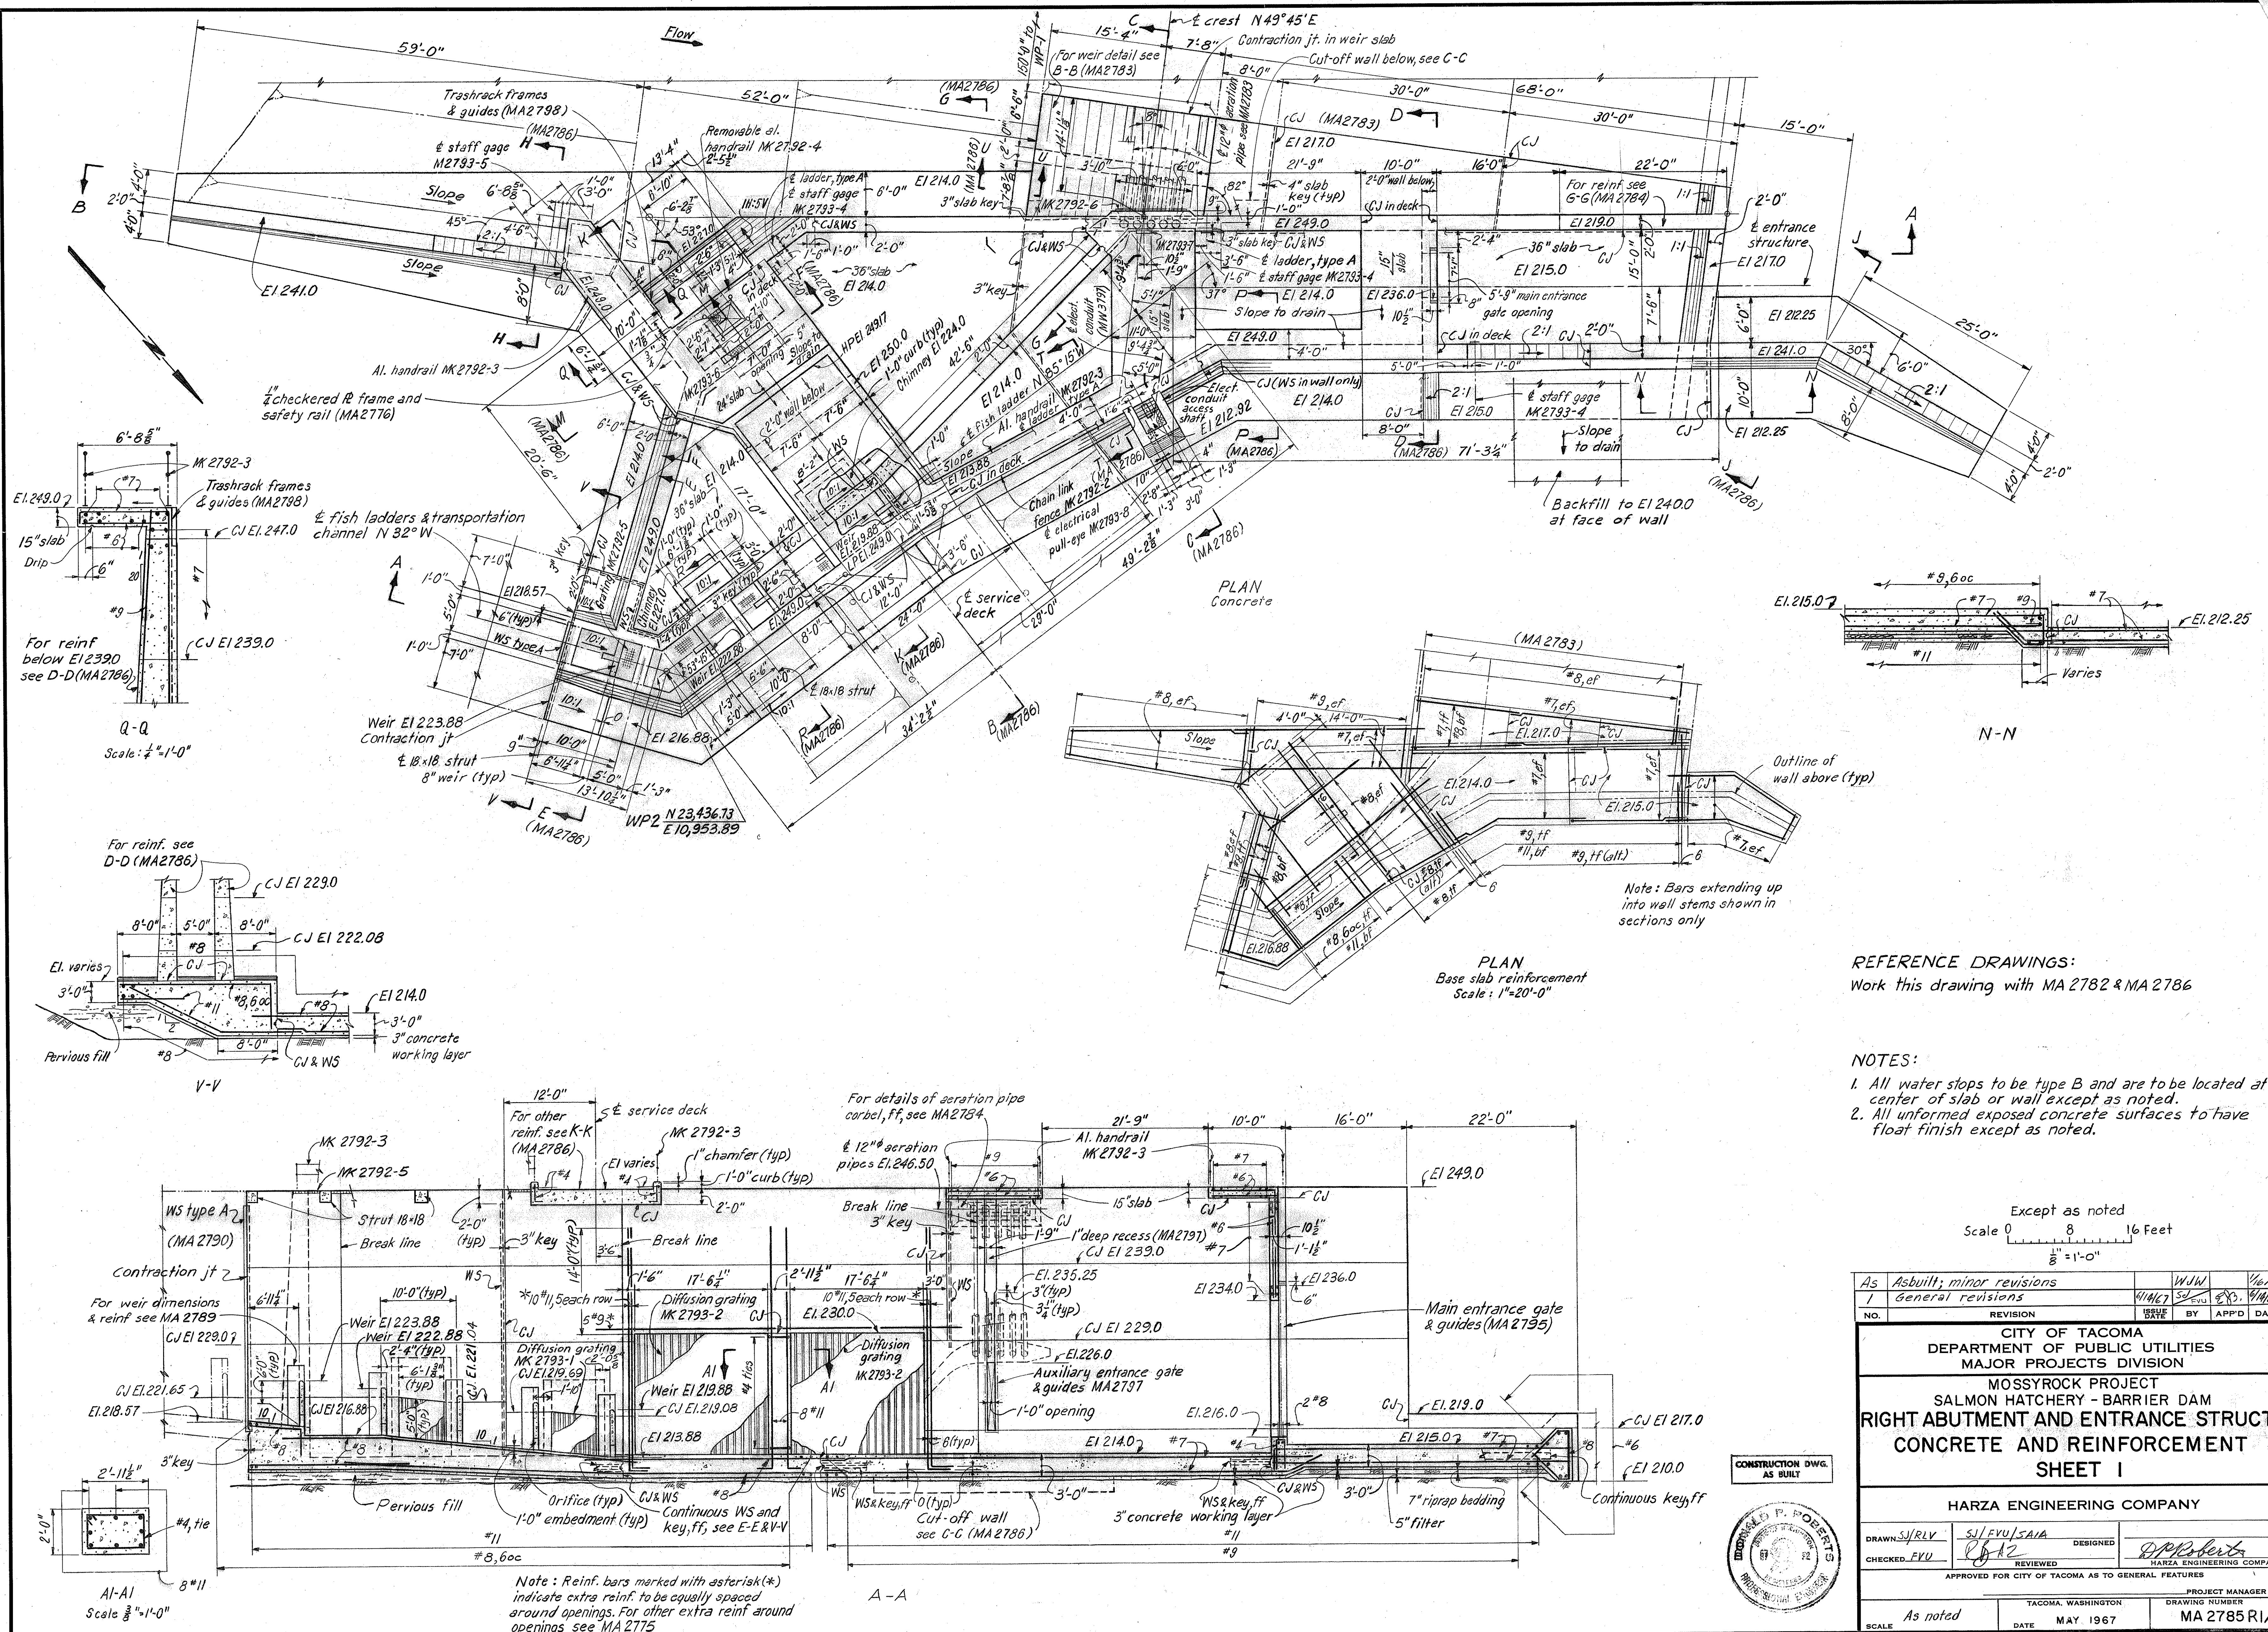


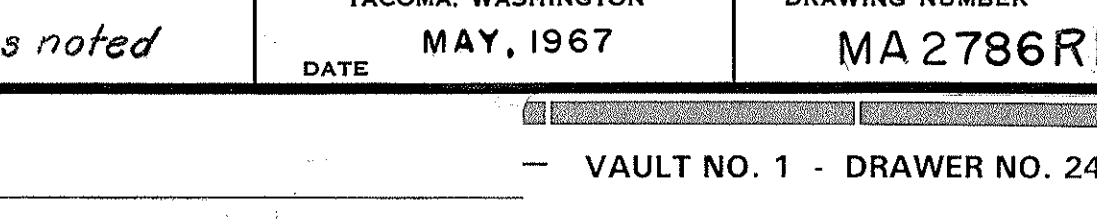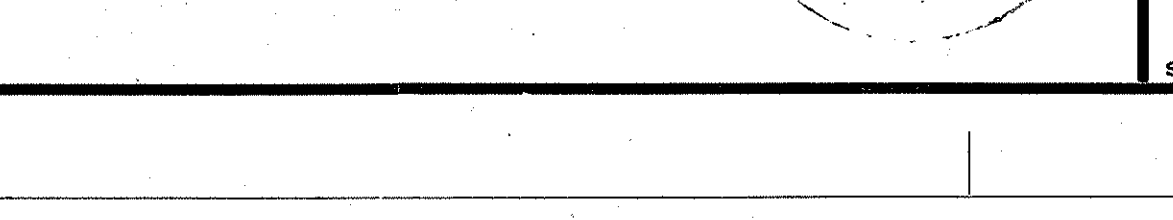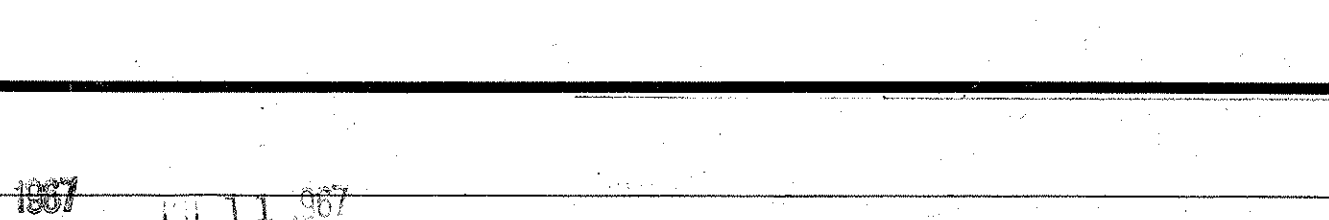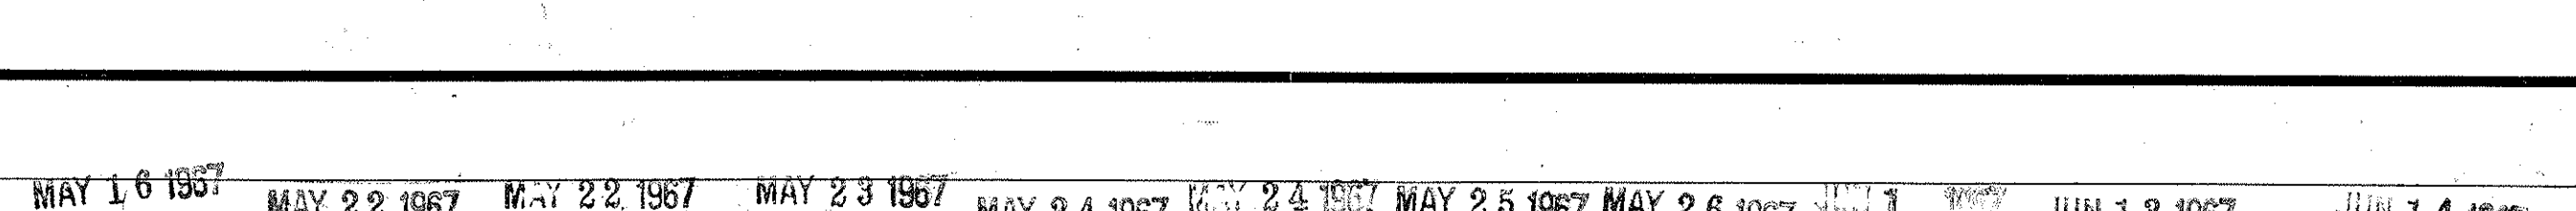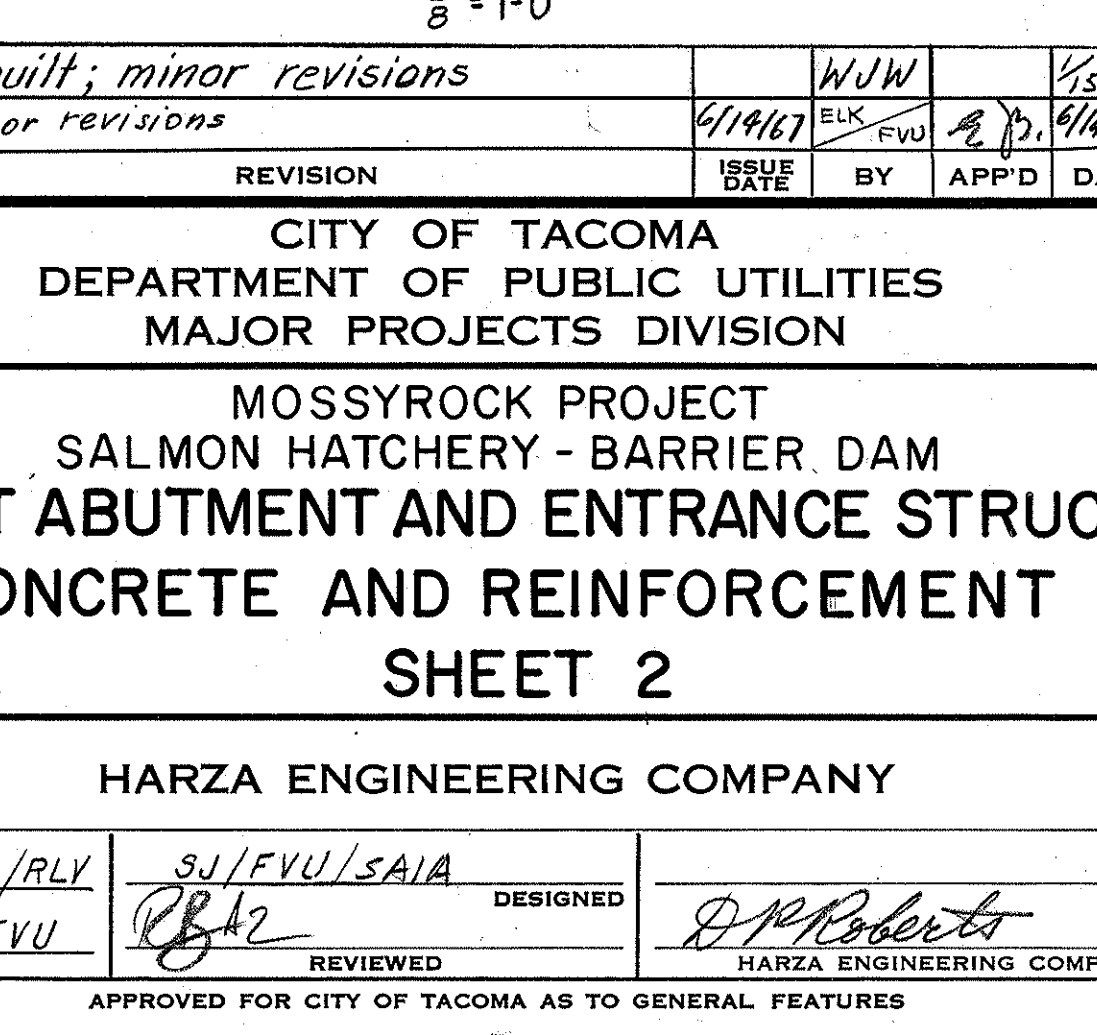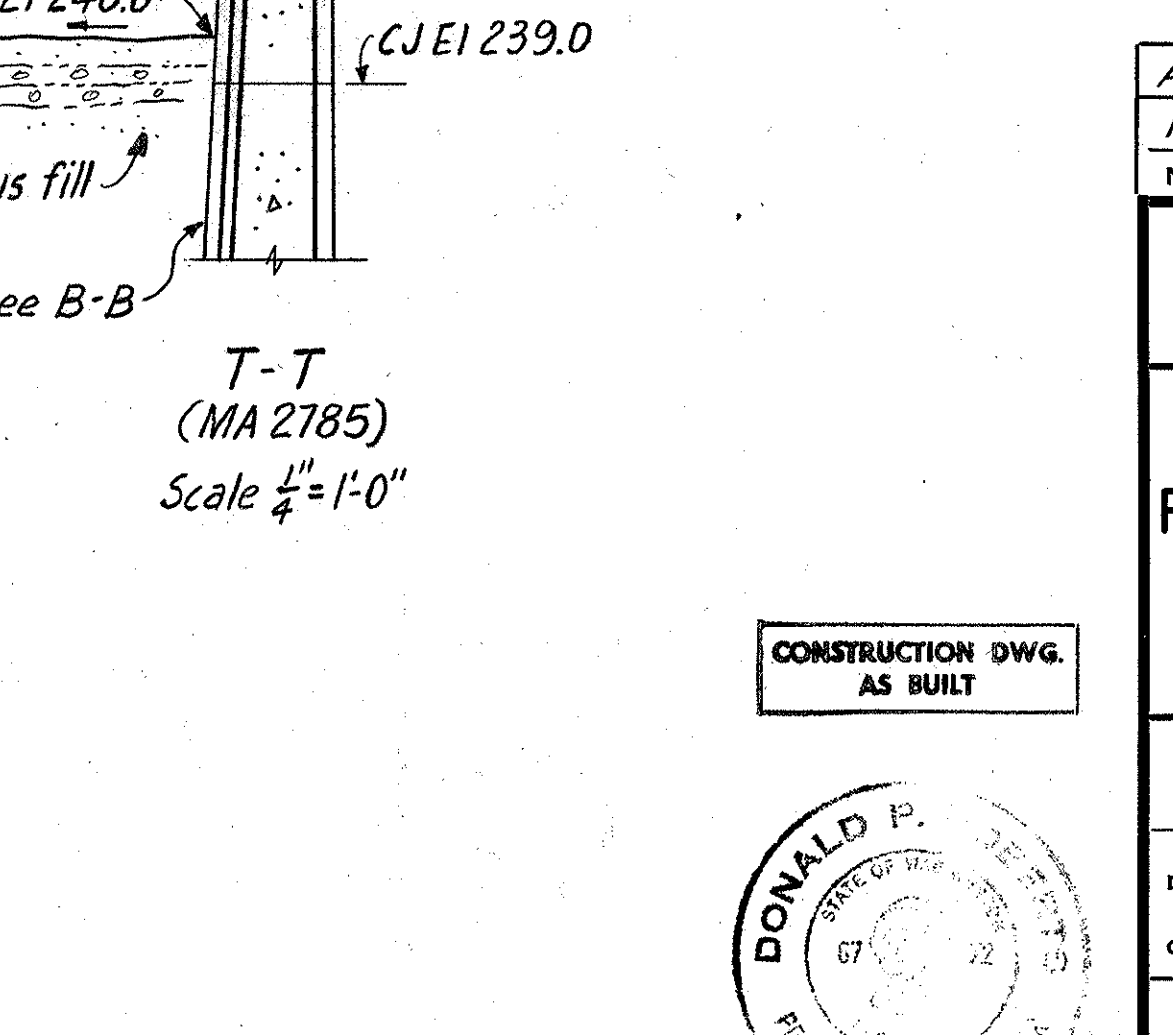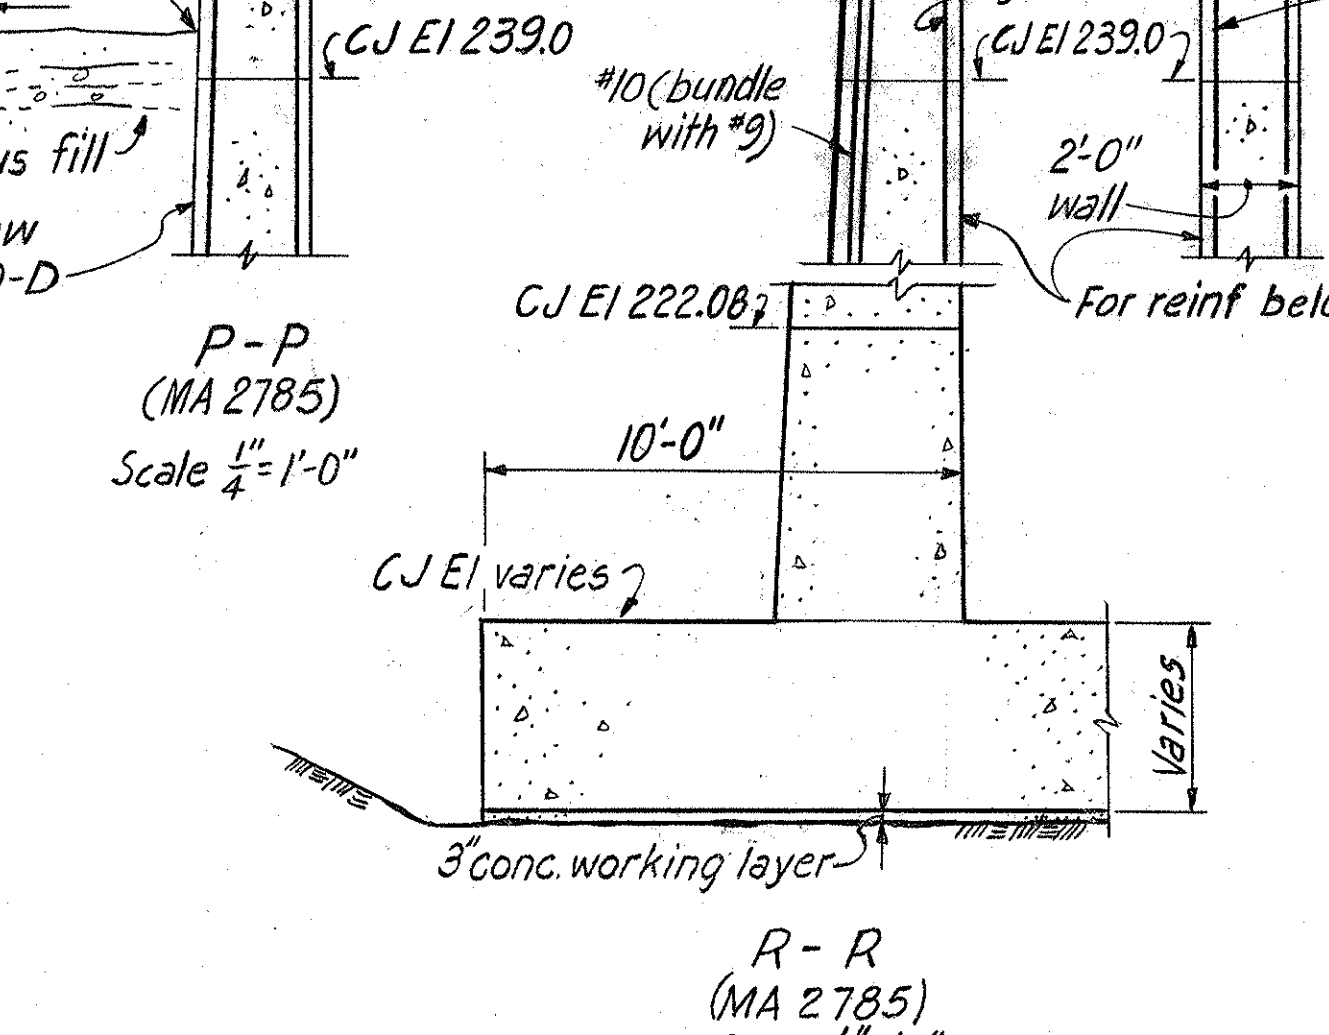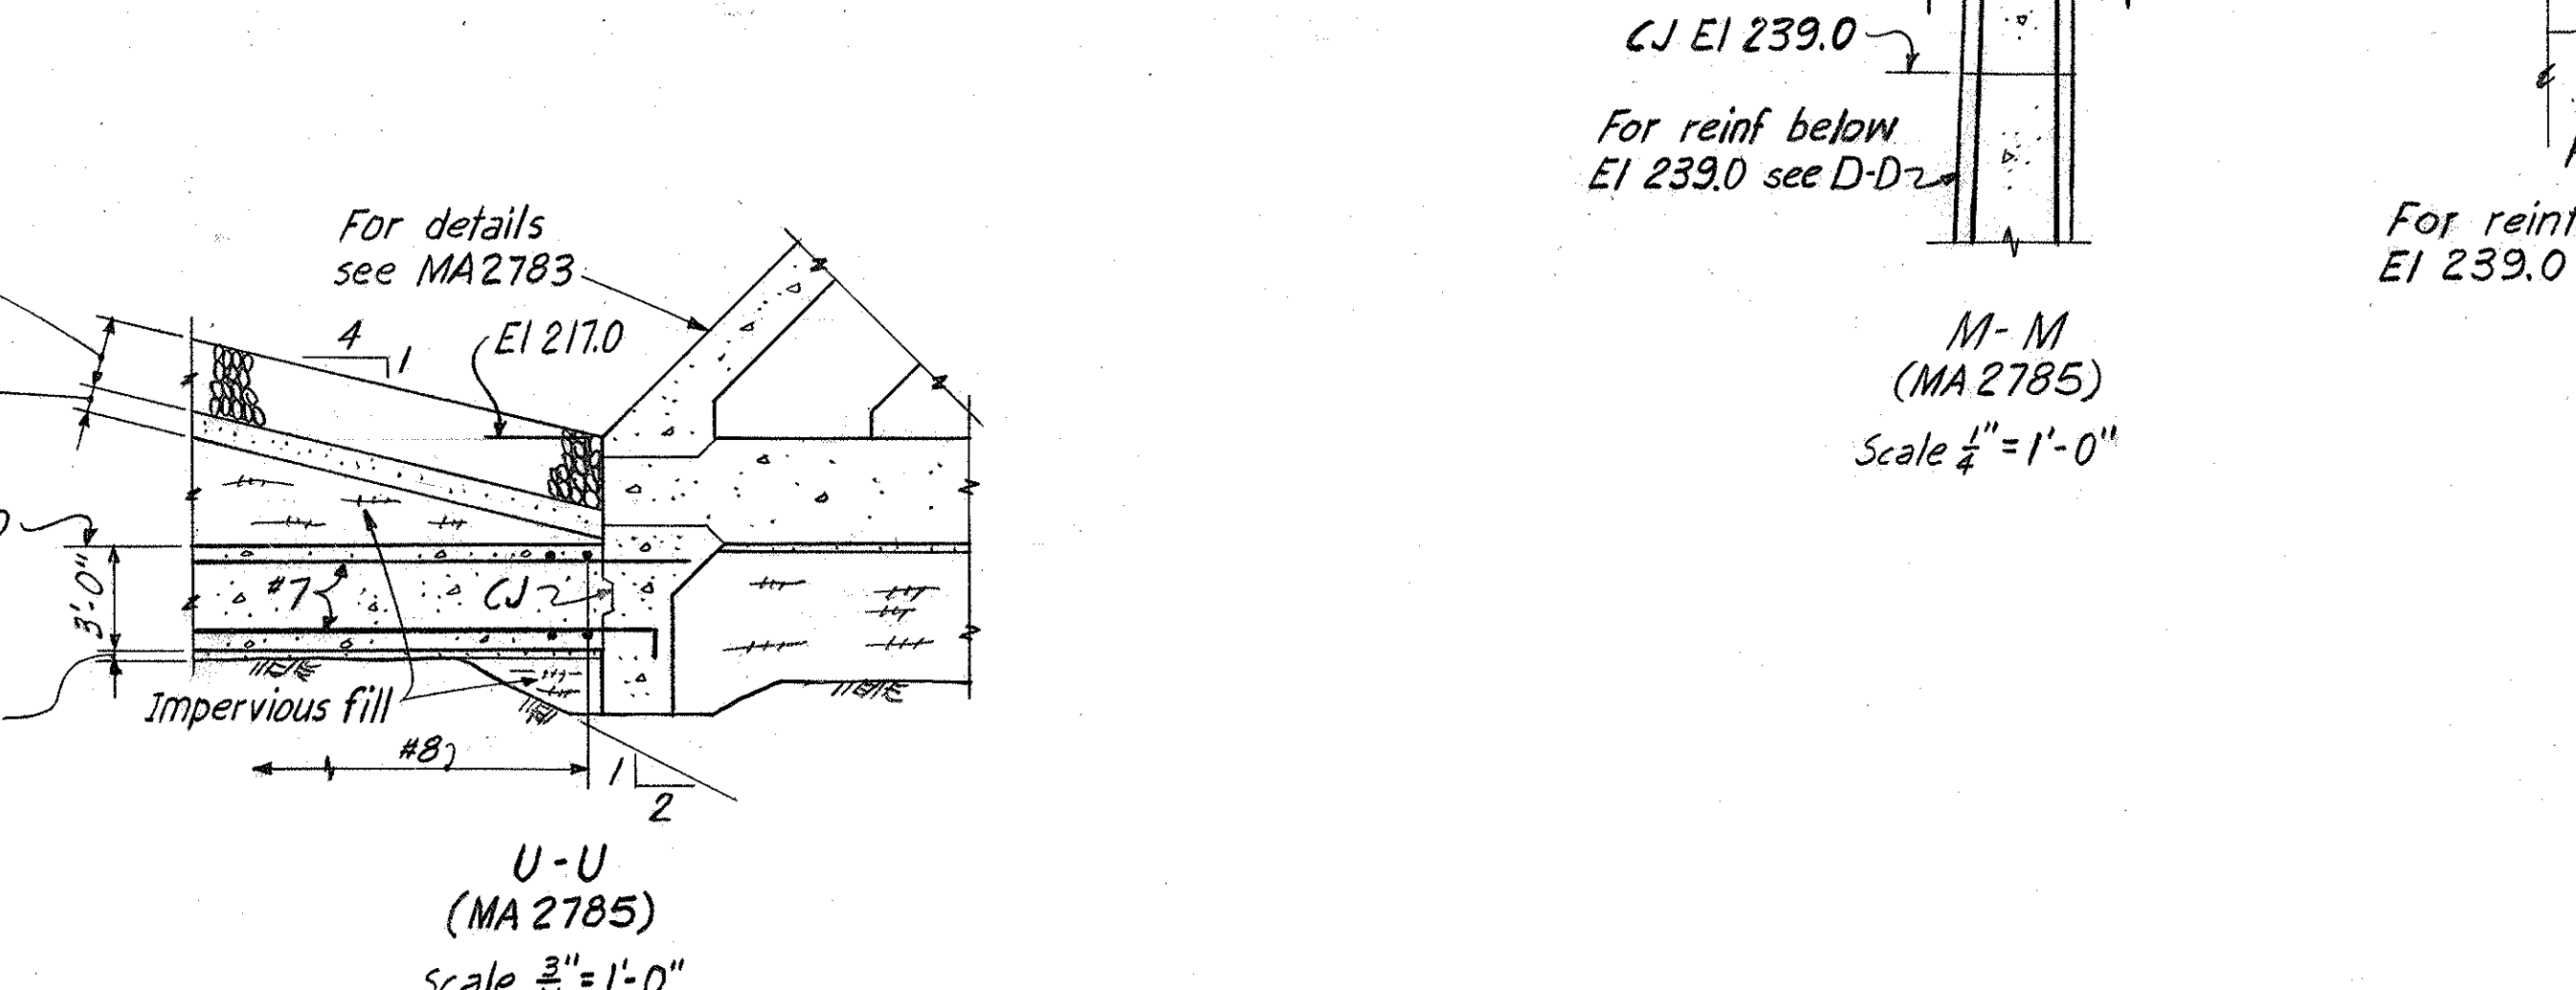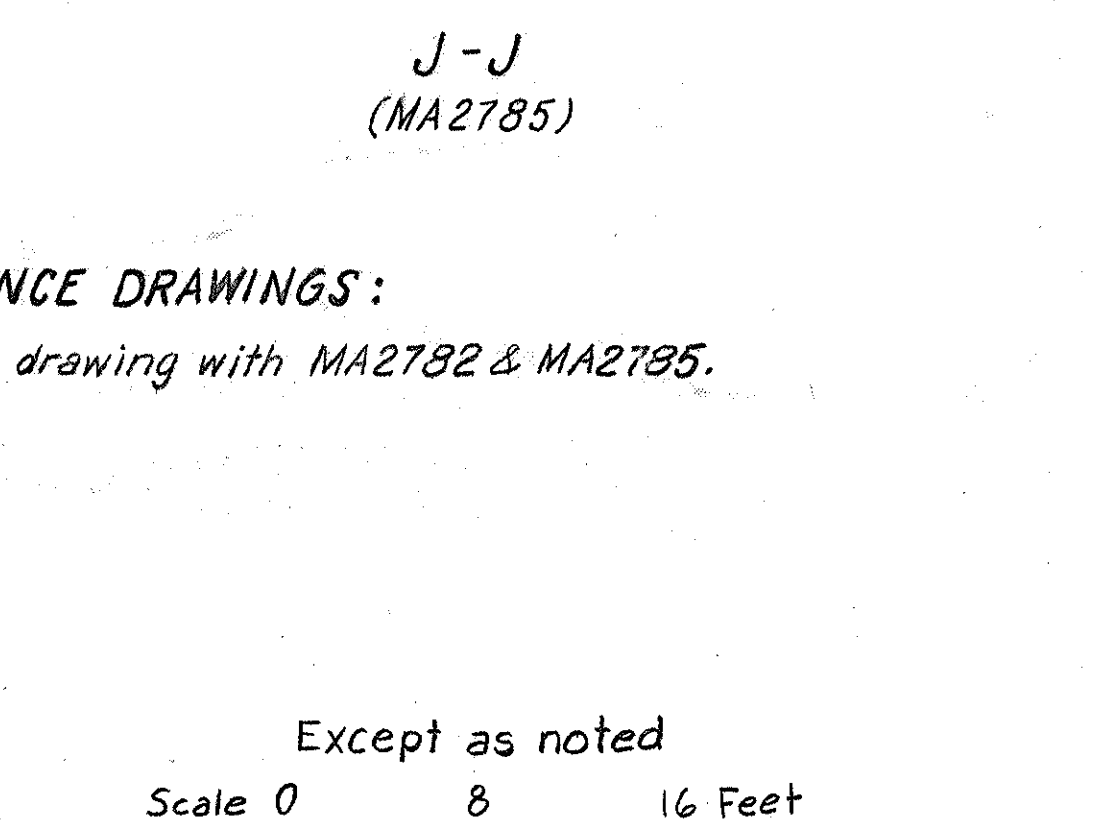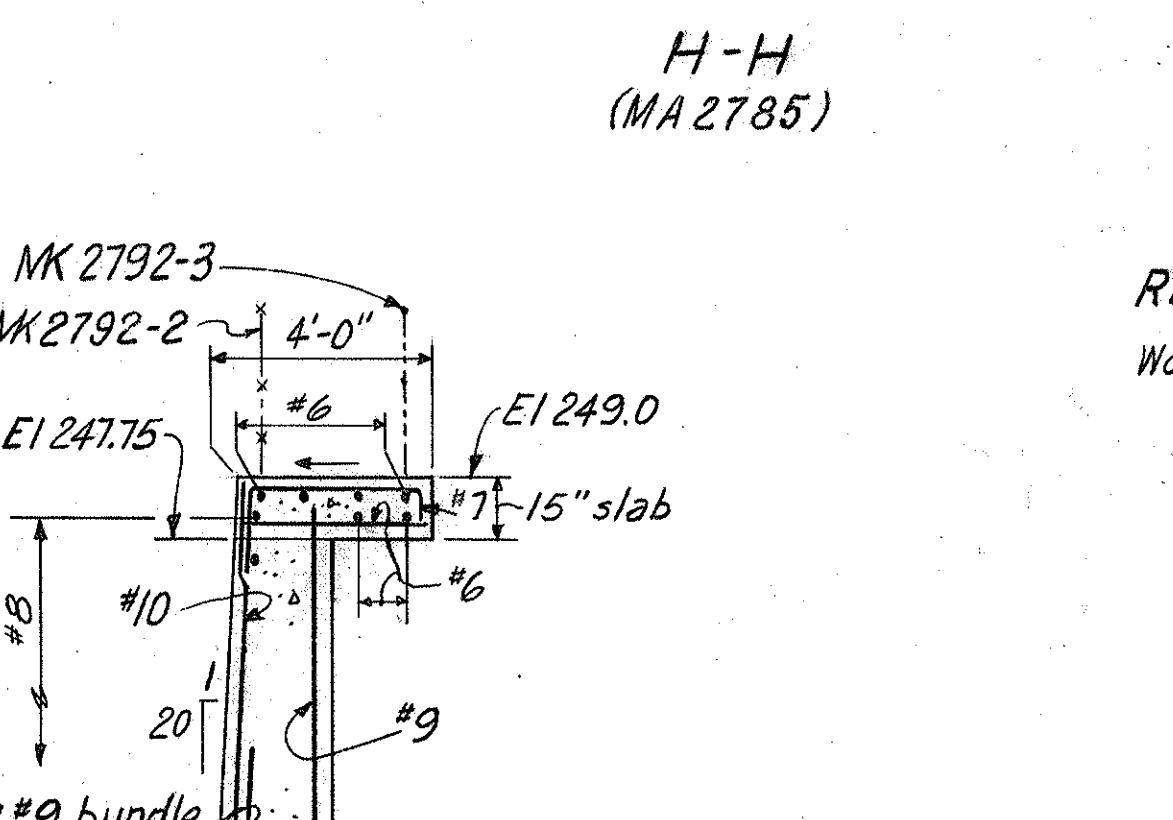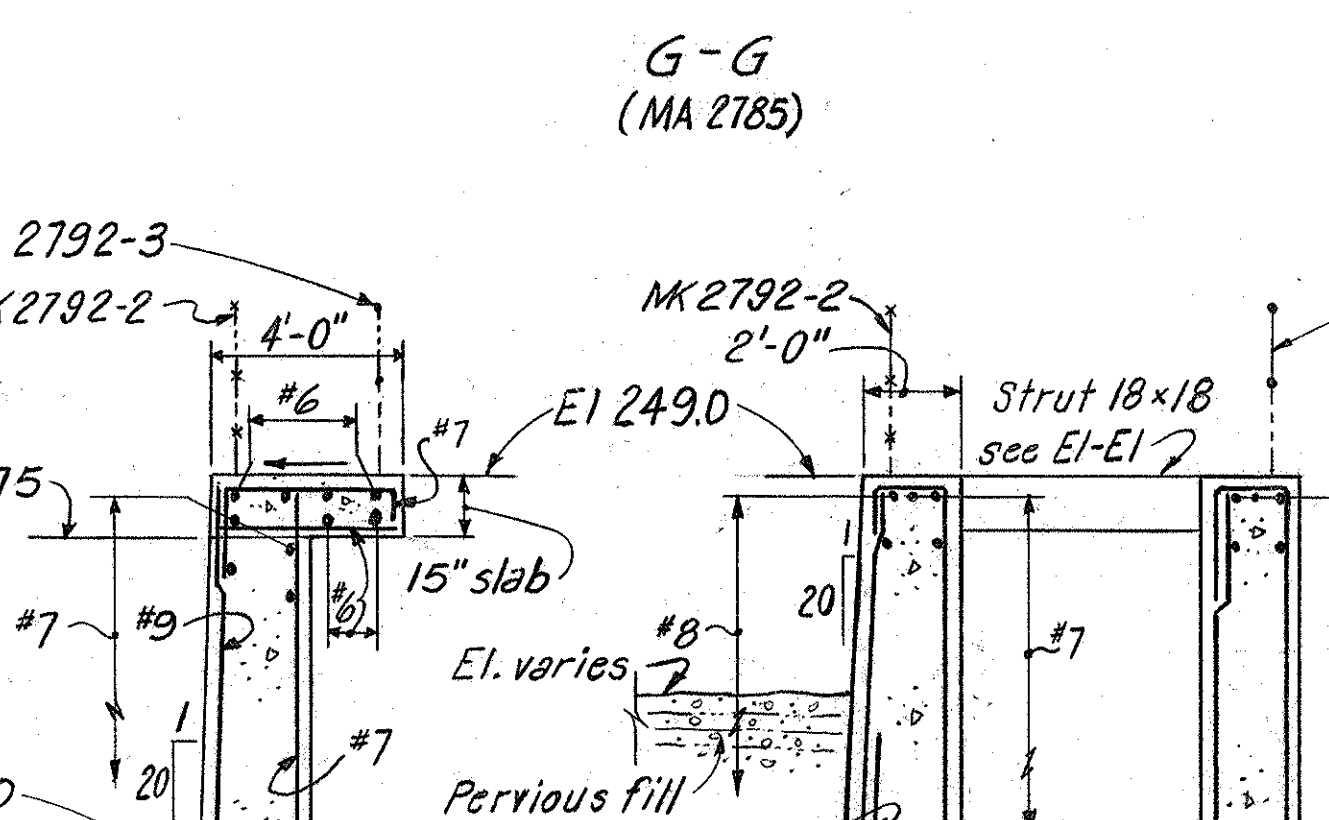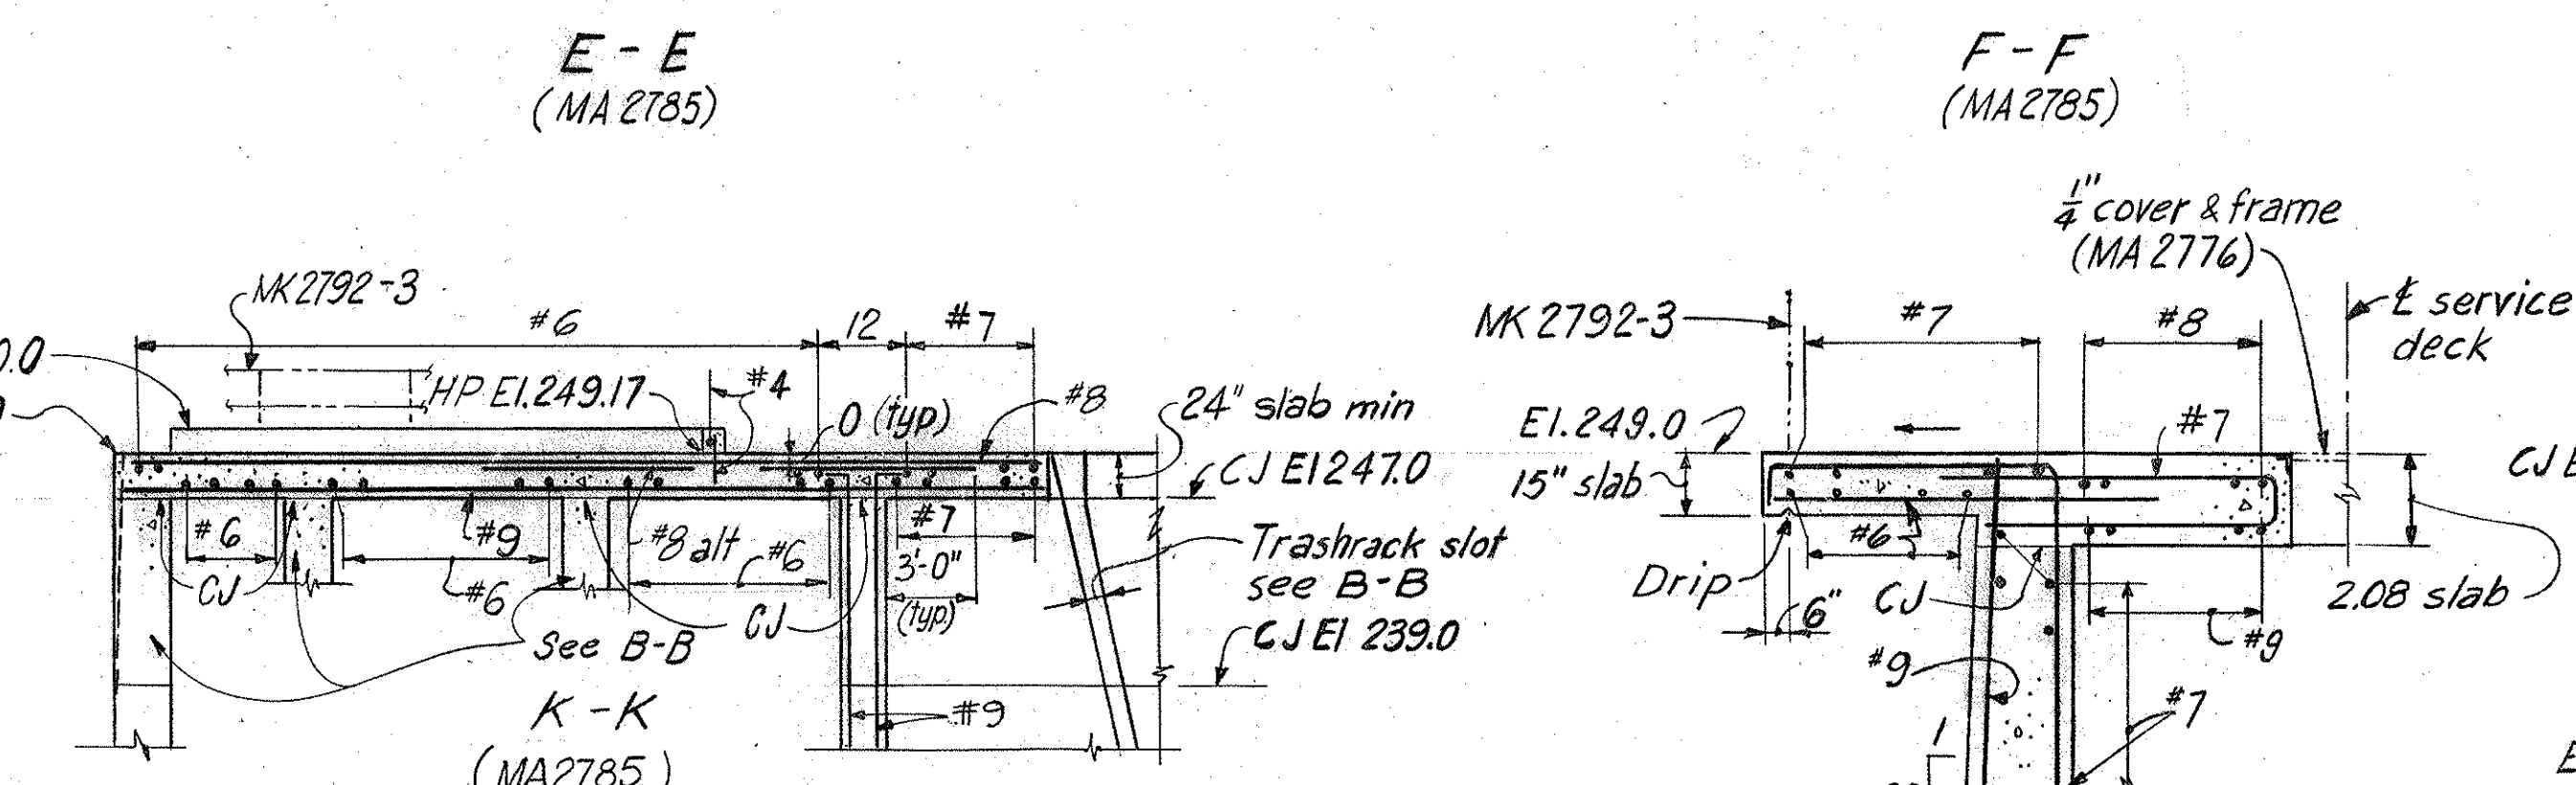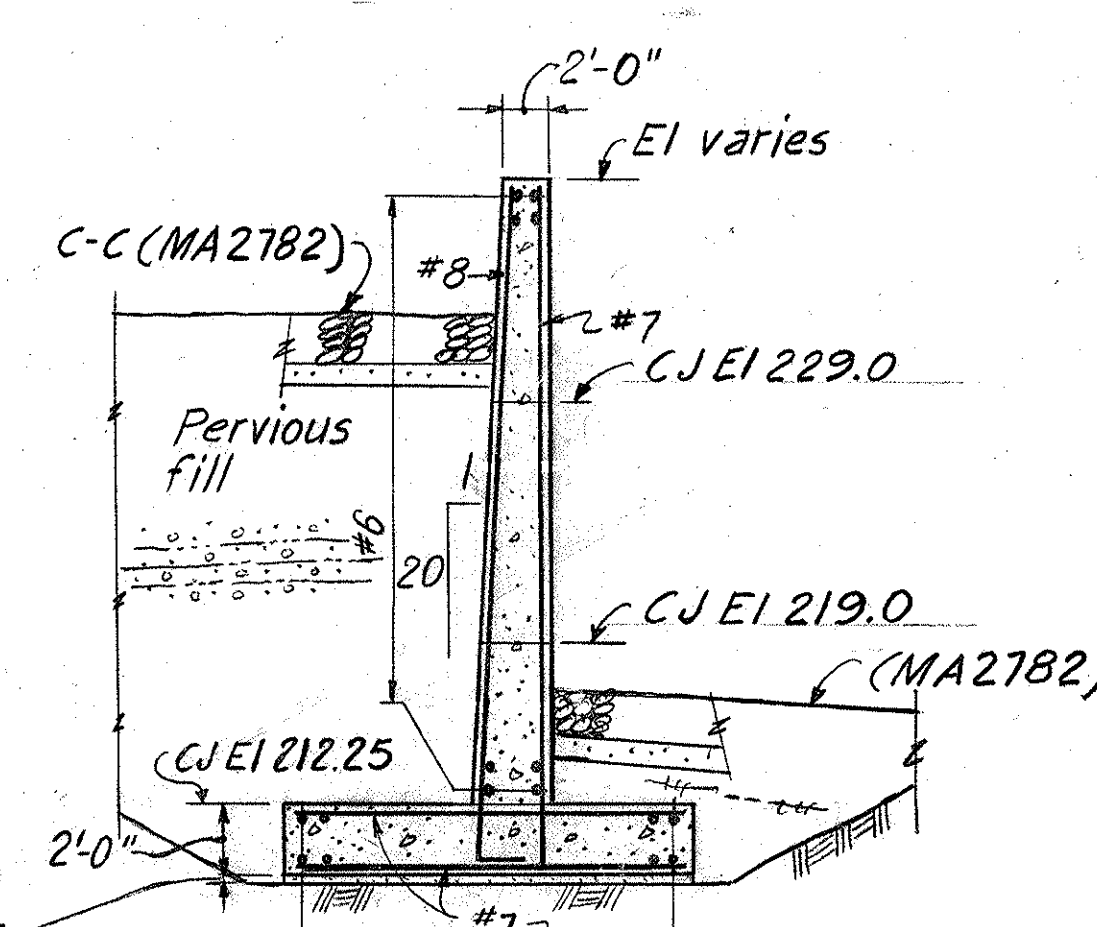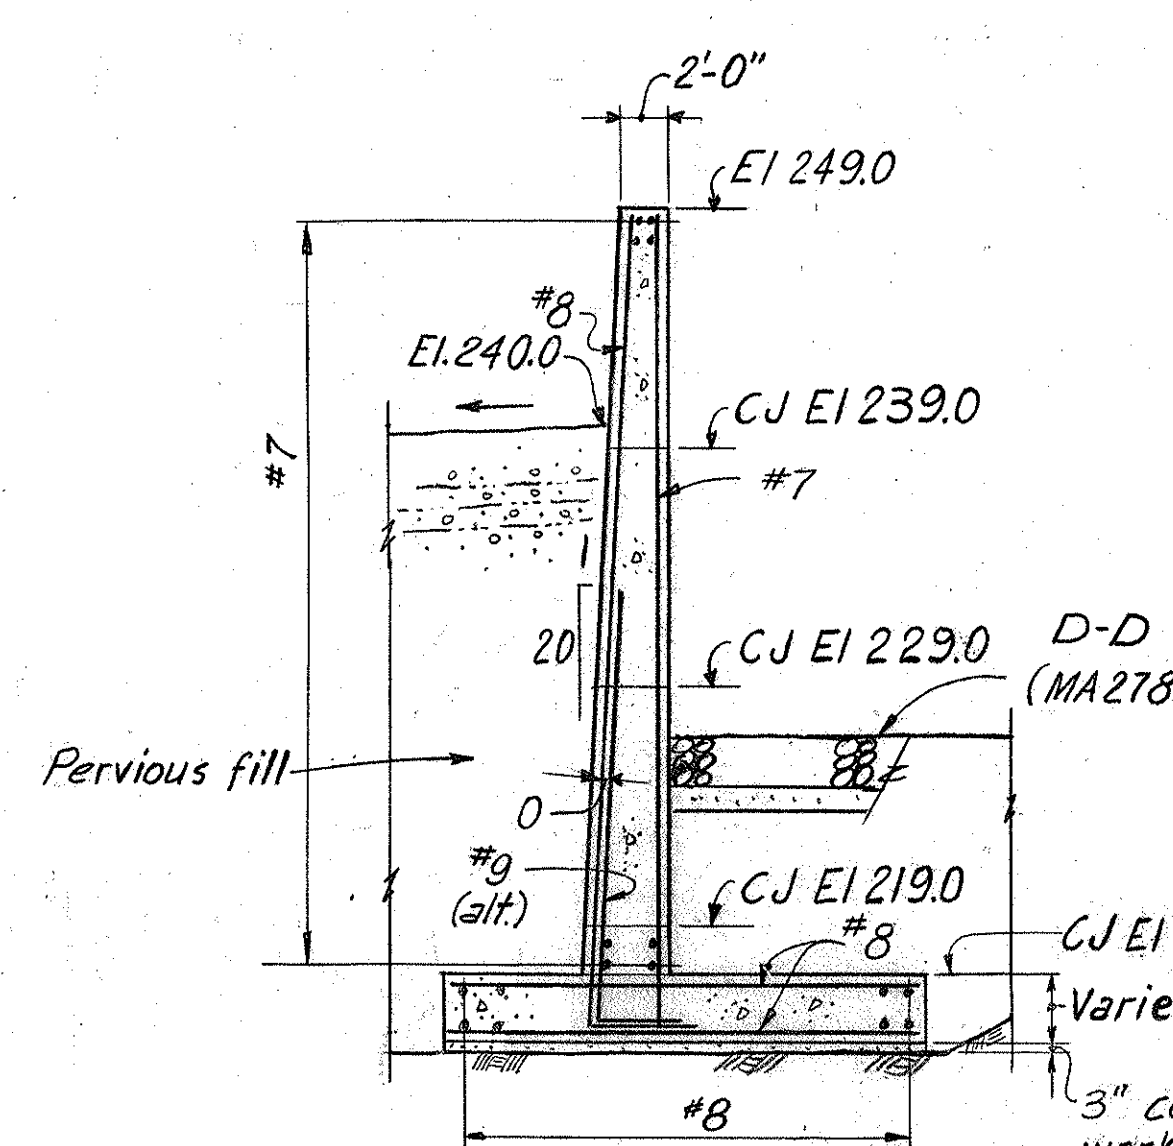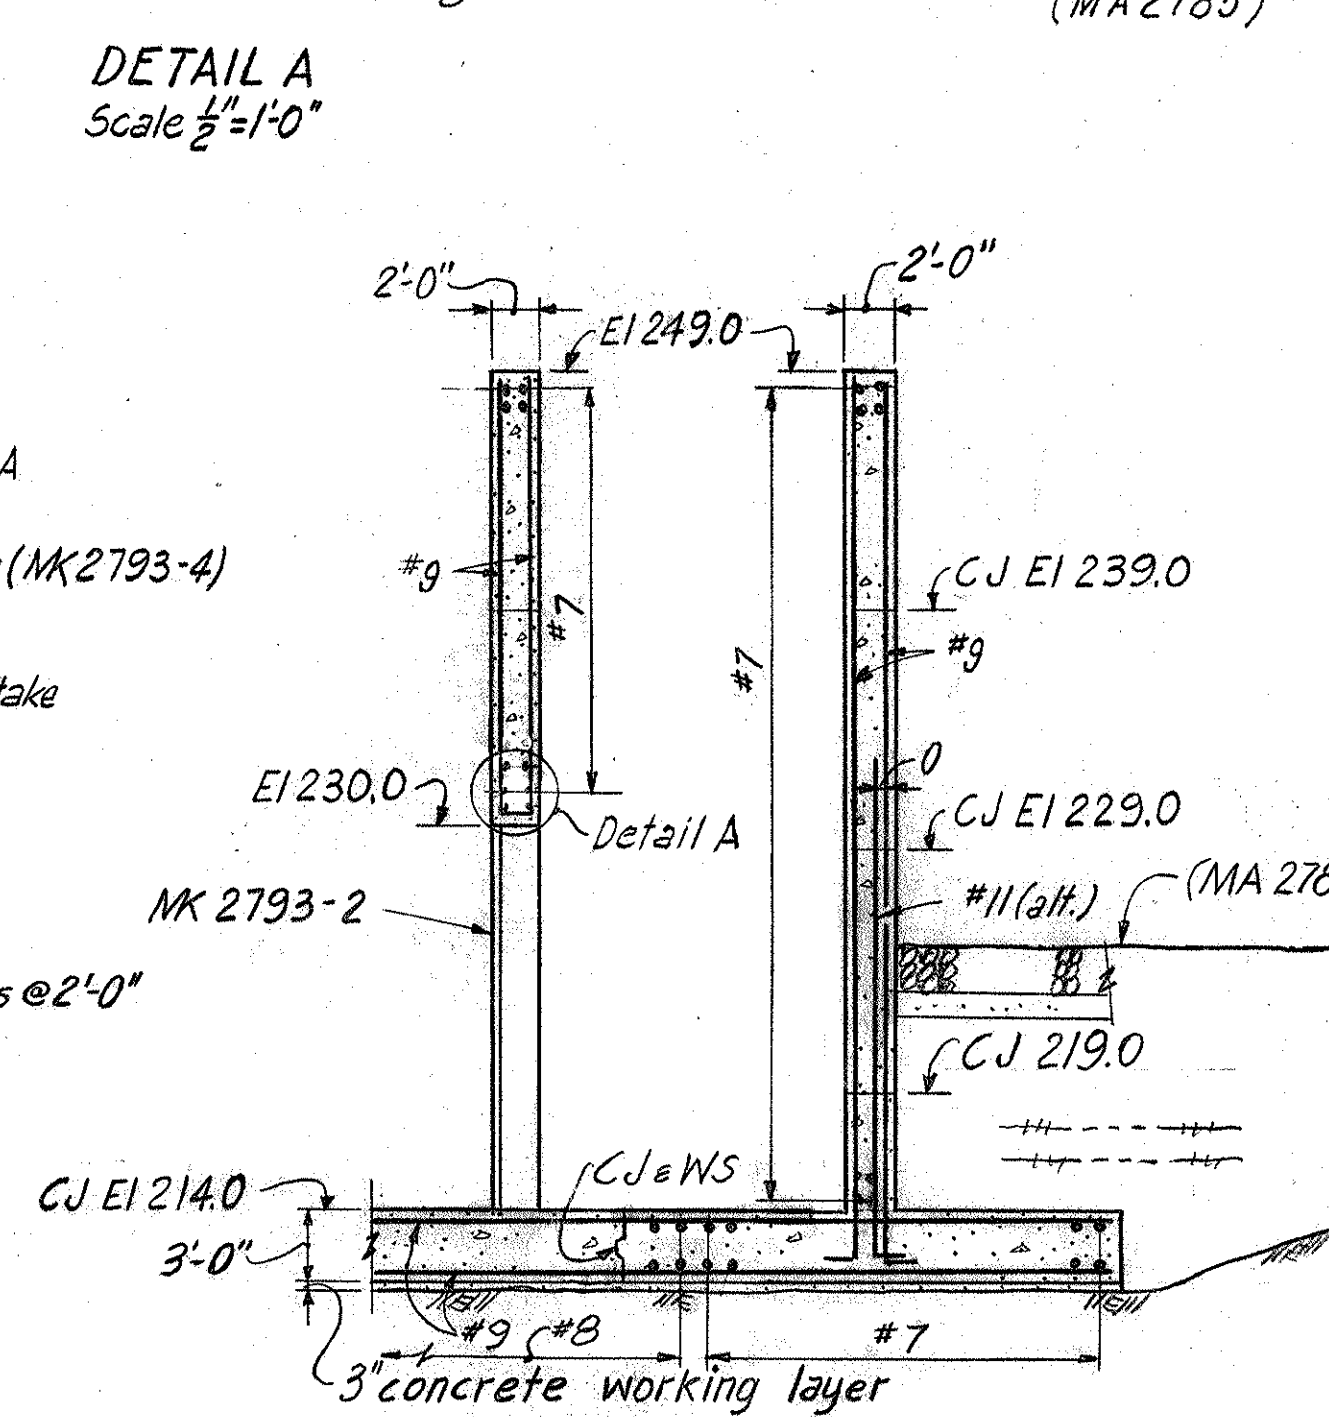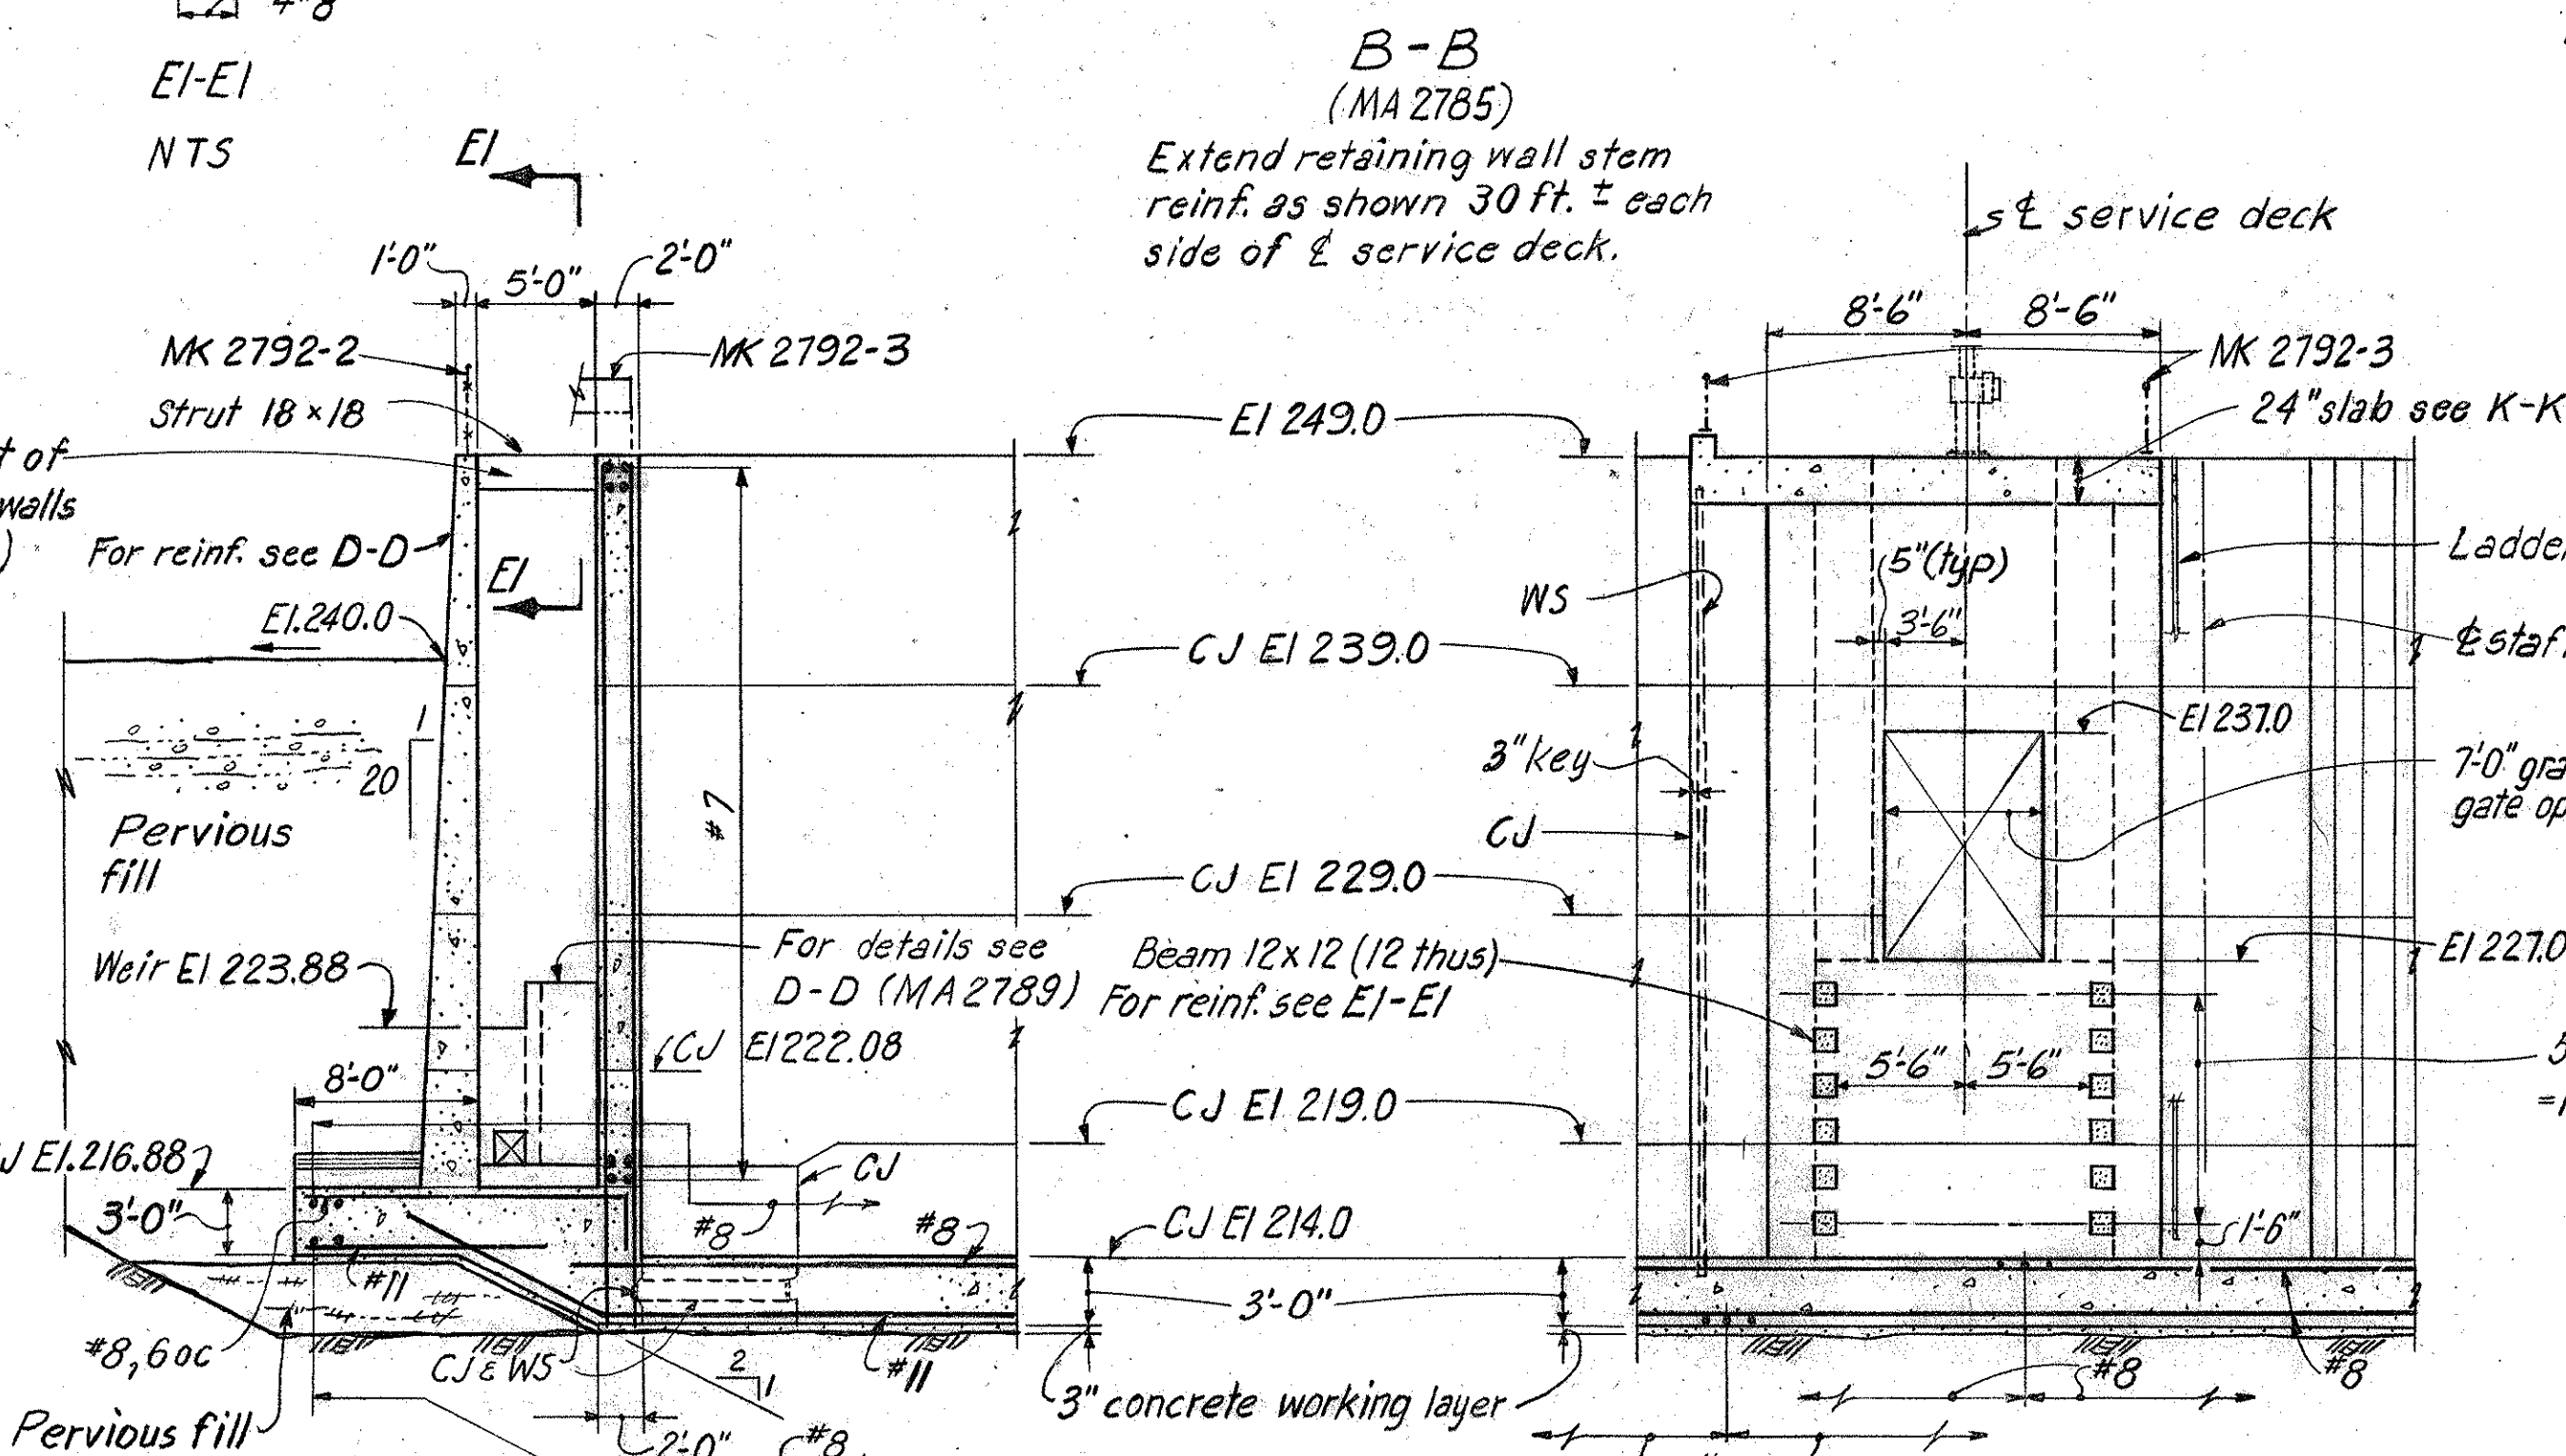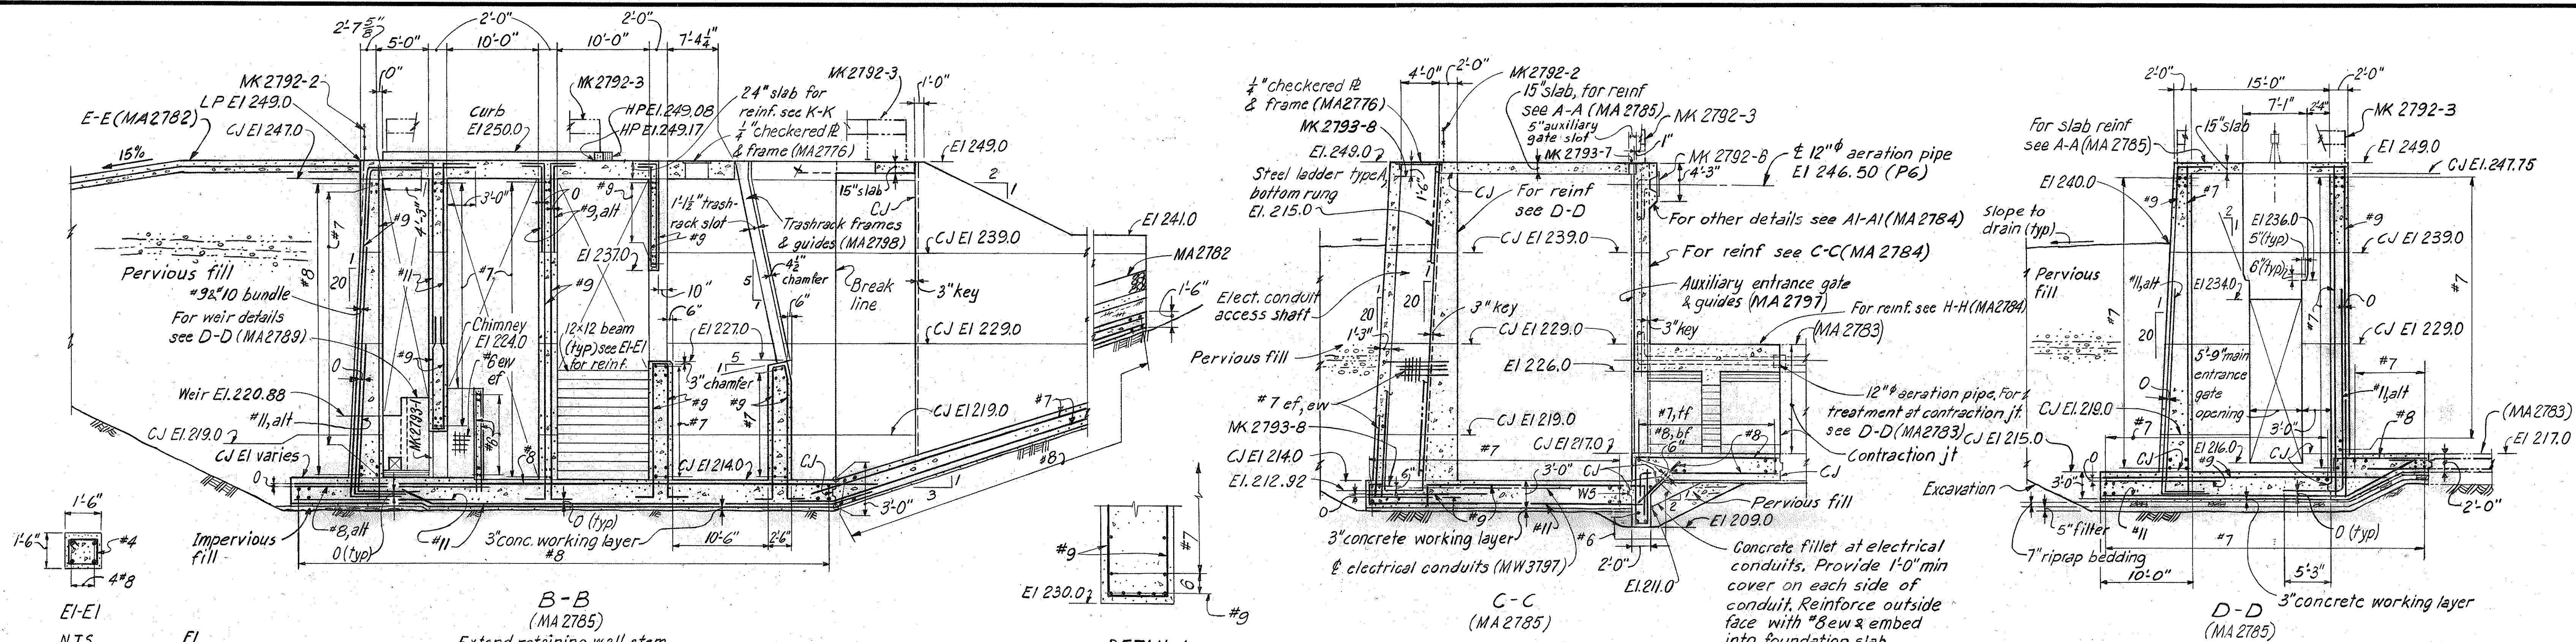


REFERENCE DRAWINGS:
Work this drawing with MA 2782 & MA 2785.

Except as noted
Scale 0 8 16 Feet
1\"/>

As	Asbuilt; minor revisions	W/JW	1/5/69
1	Minor revisions	4/19/67	4/19/67
NO.	REVISION	DATE	BY
CITY OF TACOMA DEPARTMENT OF PUBLIC UTILITIES MAJOR PROJECTS DIVISION			
MOSSYROCK PROJECT SALMON HATCHERY - BARRIER DAM RIGHT ABUTMENT AND ENTRANCE STRUCT. CONCRETE AND REINFORCEMENT SHEET 2			
HARZA ENGINEERING COMPANY			
DRAWN	SJ/RLV	SJ/FVU/SAIA	DESIGNED
CHECKED	FVU	REVIEWED	HARZA ENGINEERING COMPANY
APPROVED FOR CITY OF TACOMA AS TO GENERAL FEATURES			
TACOMA, WASHINGTON		PROJECT NUMBER	
DATE		DRAWING NUMBER	
SCALE		MA 2786R/AS	

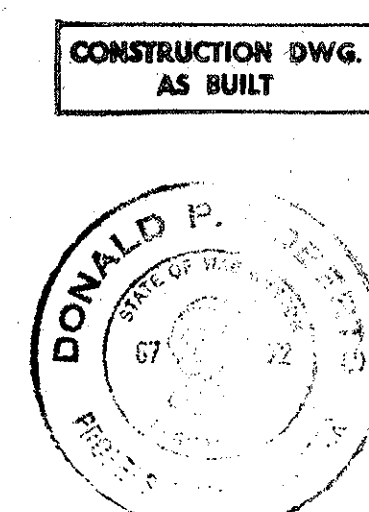

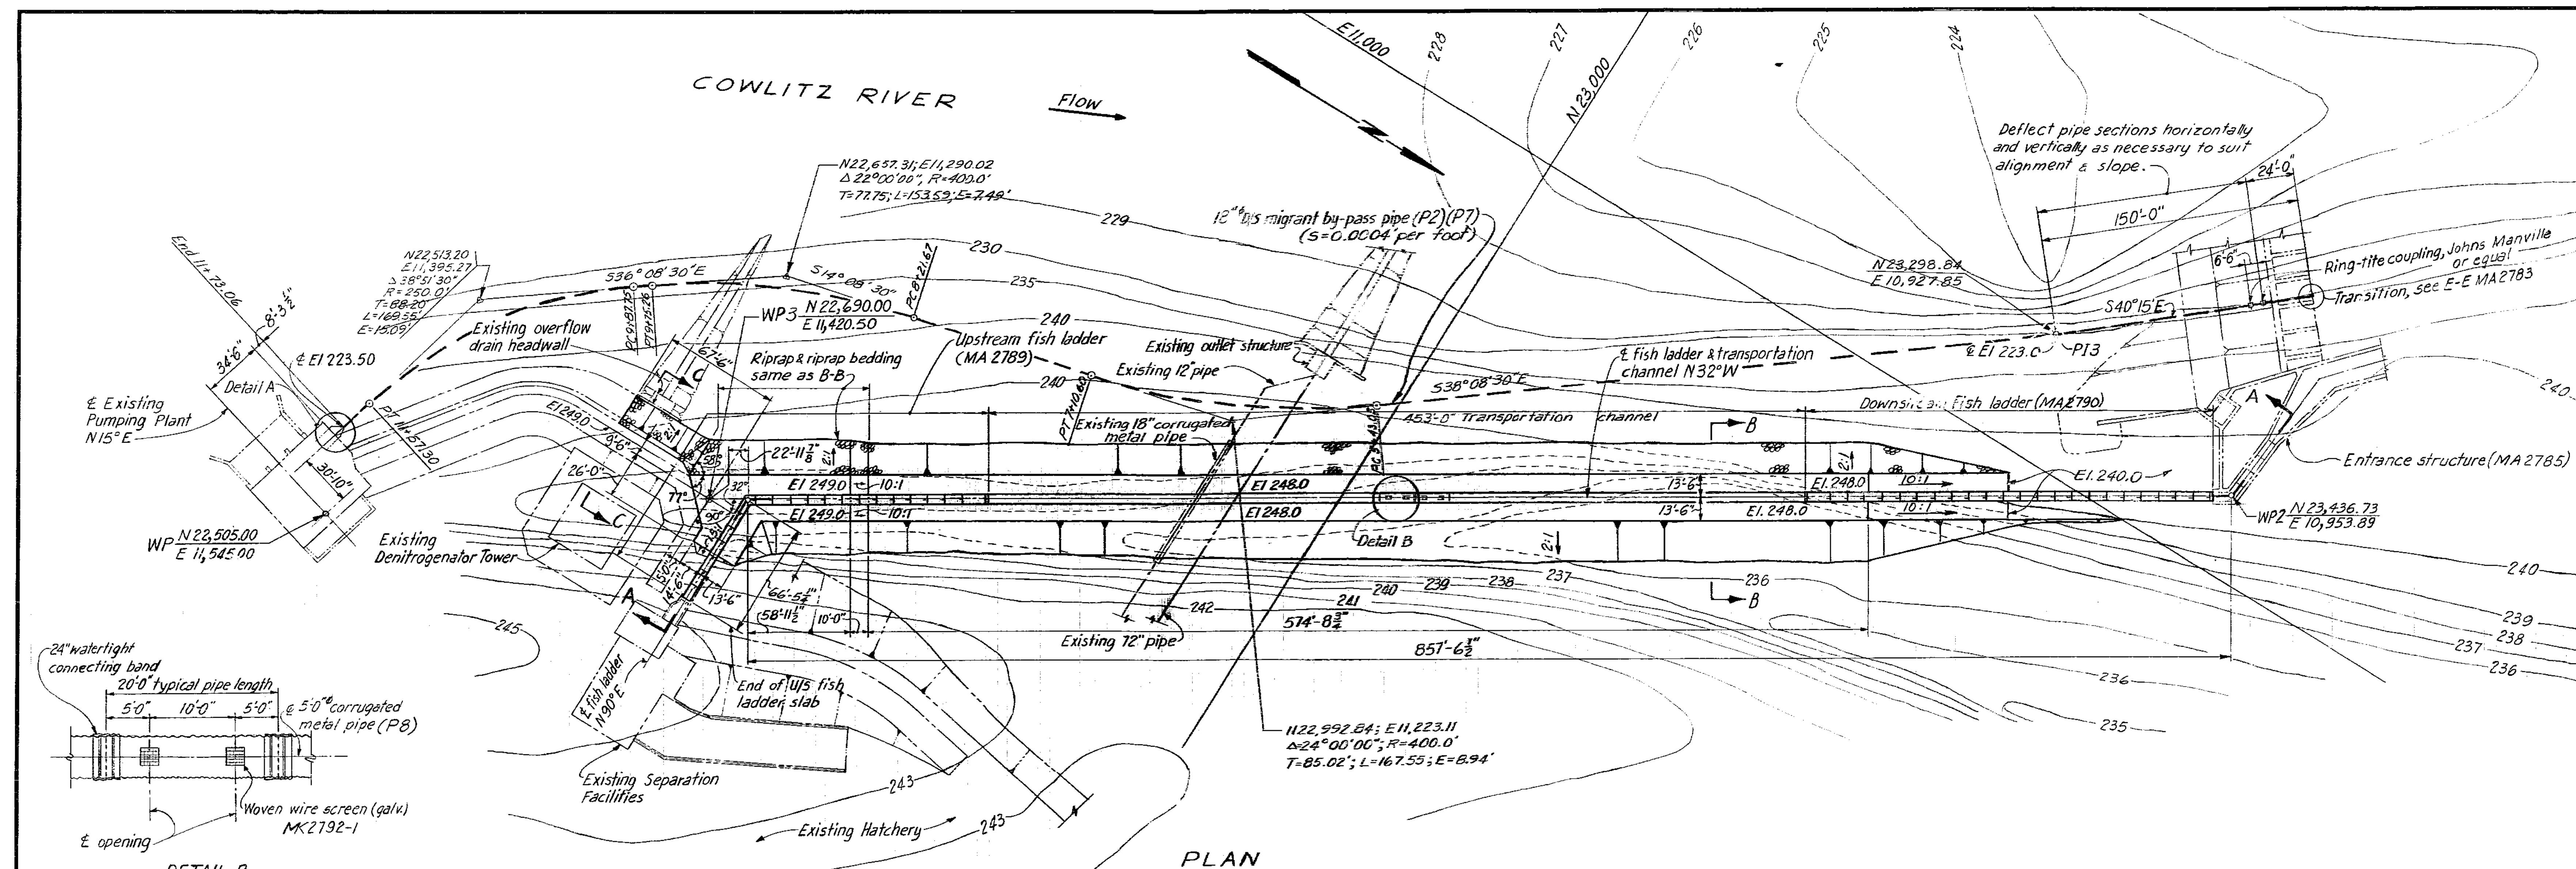


PLAN

REFERENCE DRAWINGS:

Work this drawing with MA 2789 & MA 2790
Excavation MA 2778
General Plan- Fish Barrier, Abutments
and Entrance Structures MA 2782
Standard Details MA 2775


NOTES:

- The alignment of the by-pass pipe adjusted by the Engineer with the limitation of joint rotations to reduce depth of excavation. Pipe has a min. cover above crown of 2 feet.

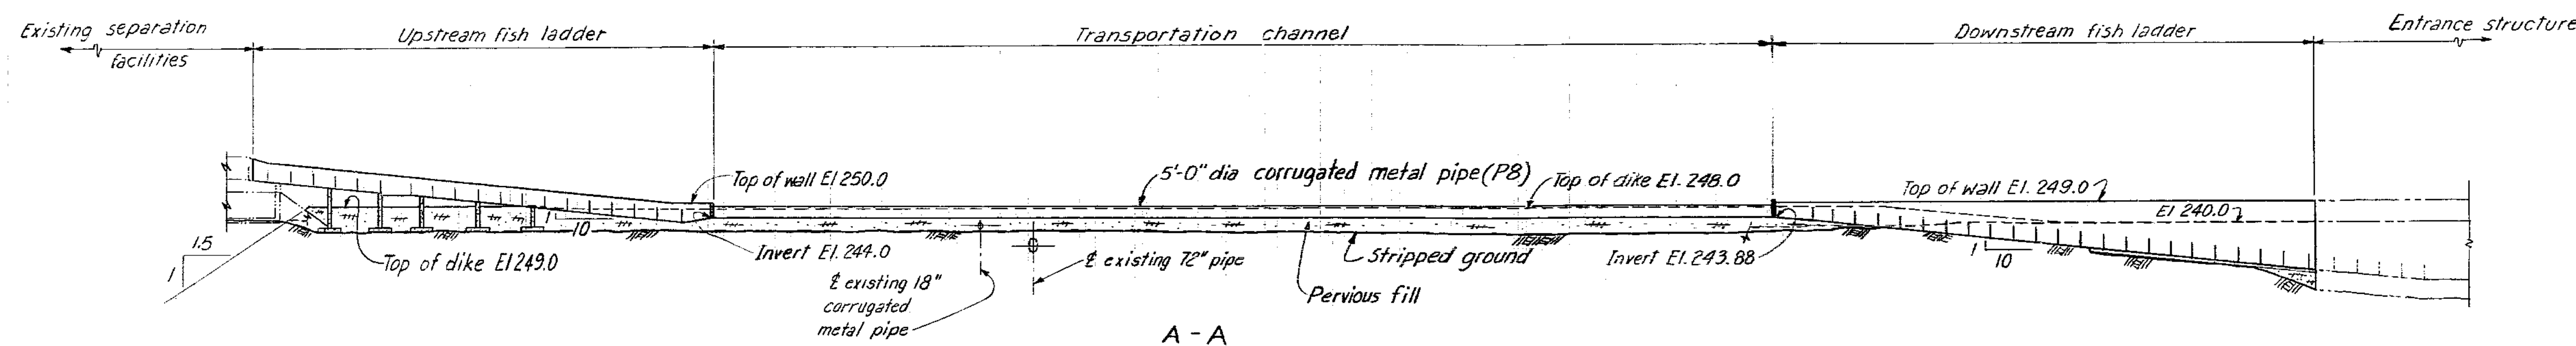


A-A


Scale 0 40 80 Feet
1" = 40'
Except as noted

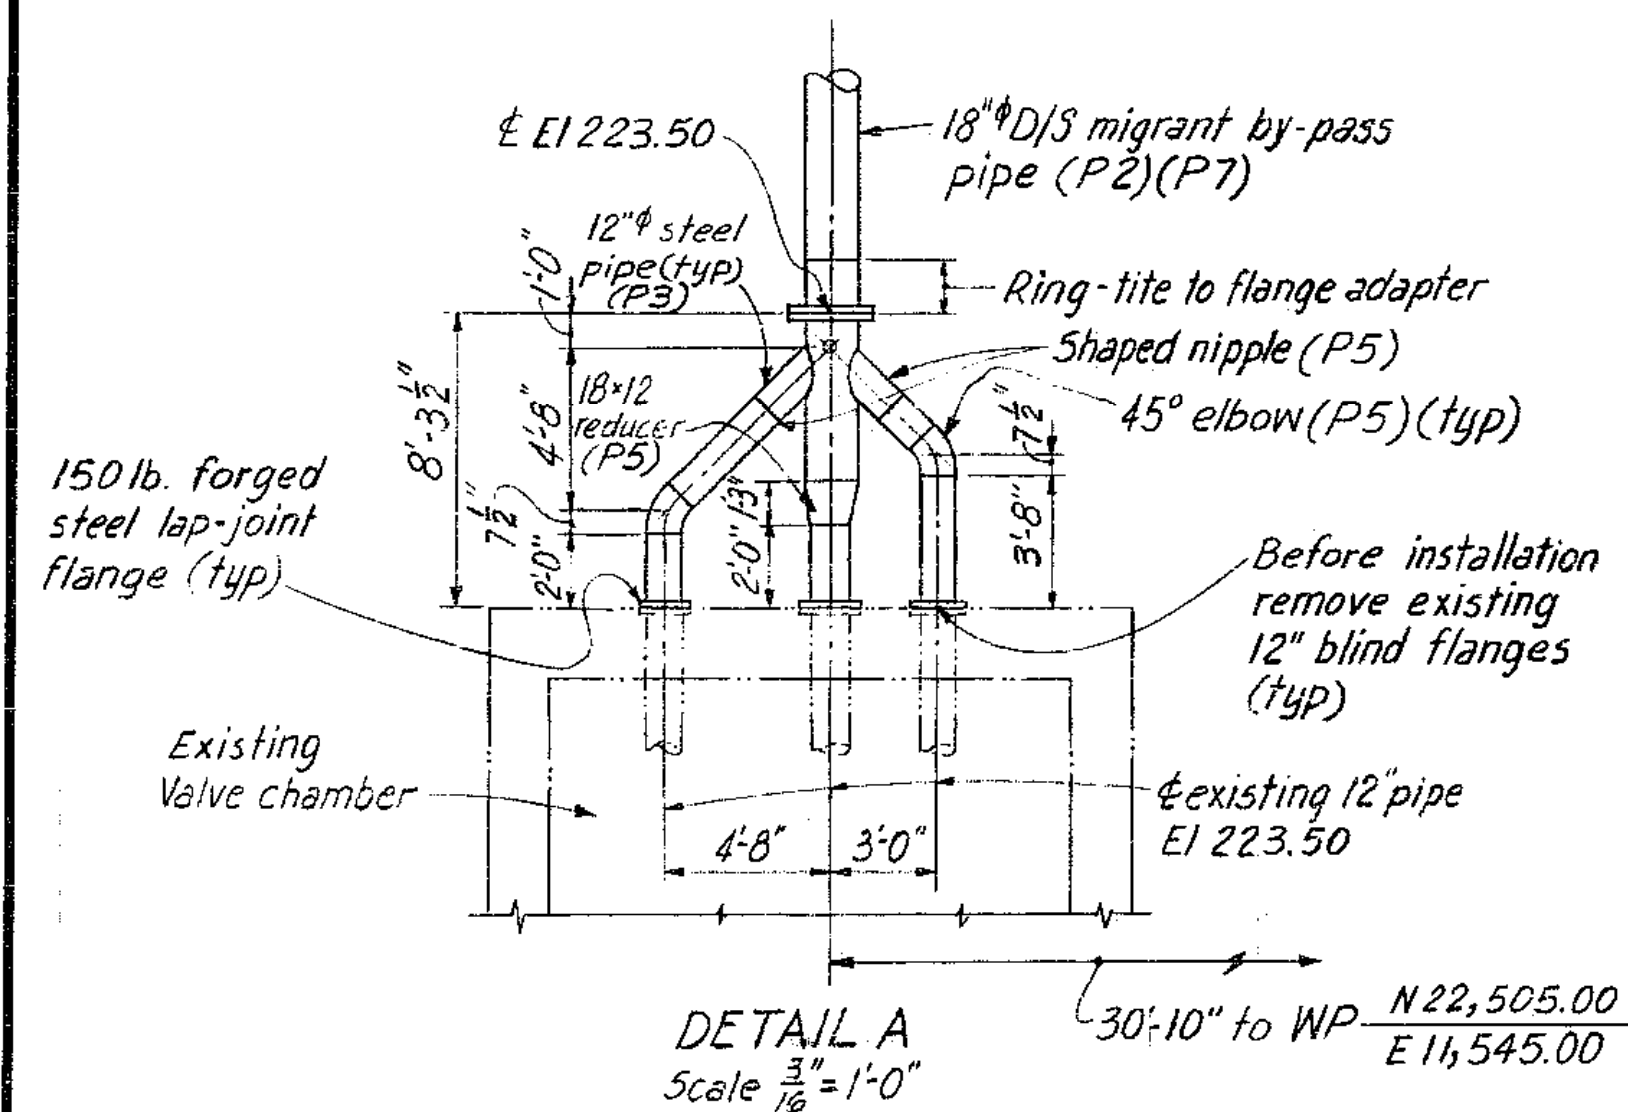

DETAIL A
Scale 1/8" = 1'-0"

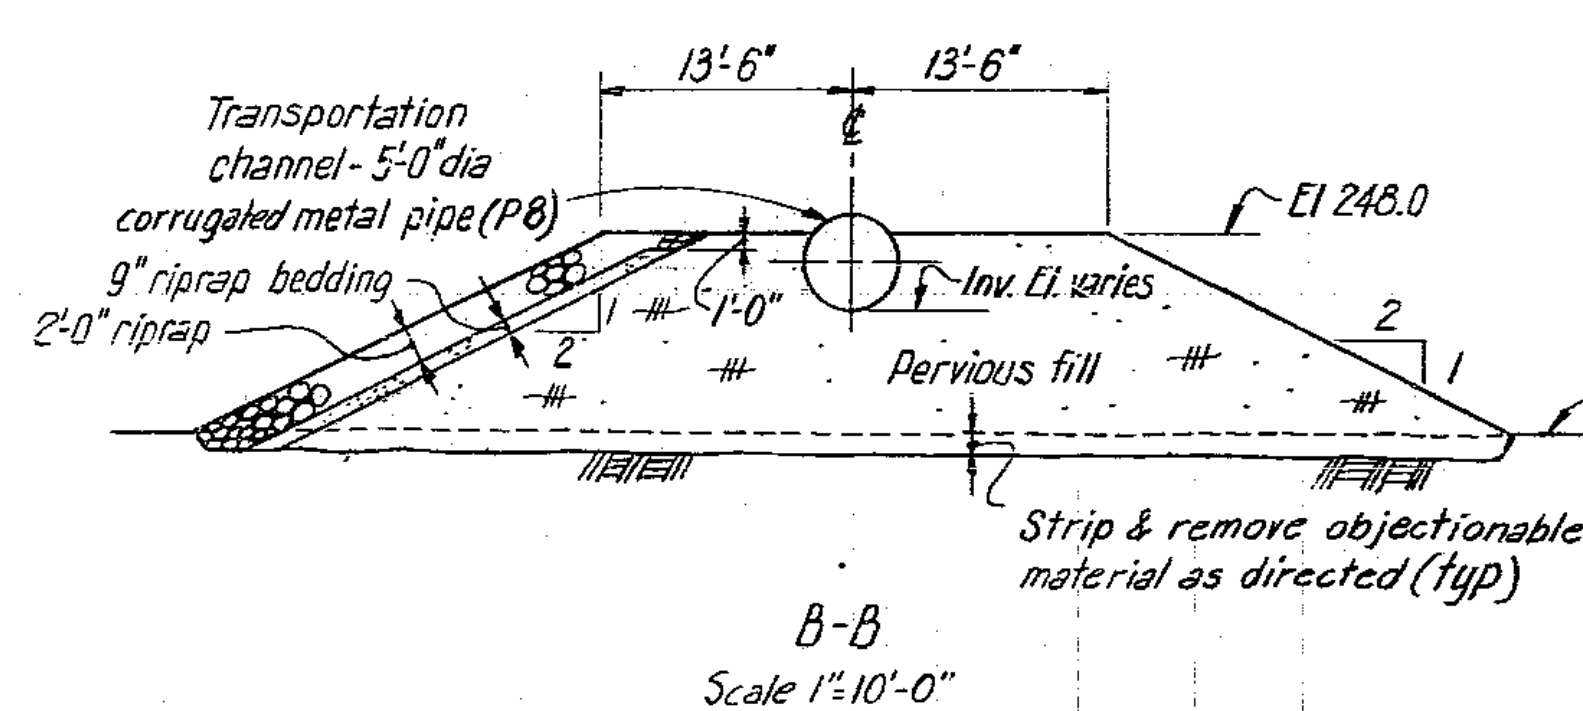


B-B
Scale 1/4" = 1'-0"

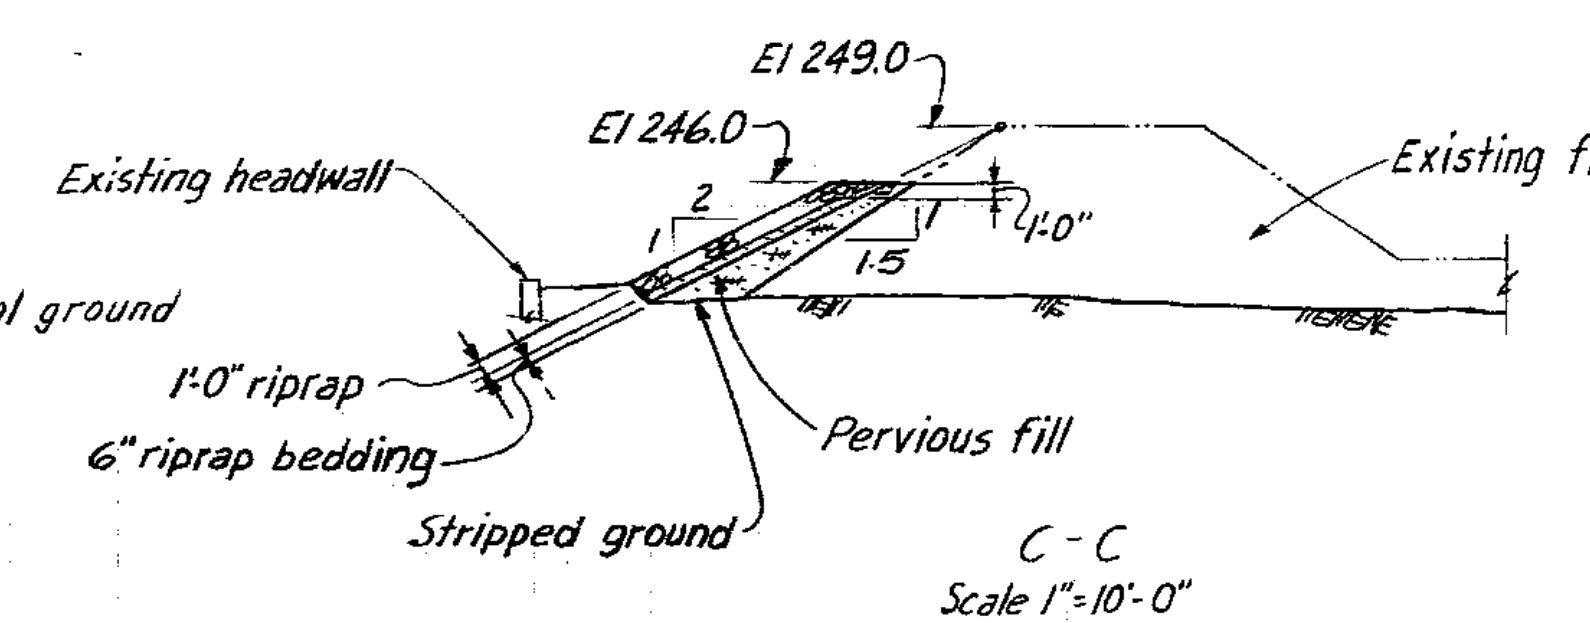



C-C
Scale 1" = 10'-0"

CONSTRUCTION DWG.
AS BUILT


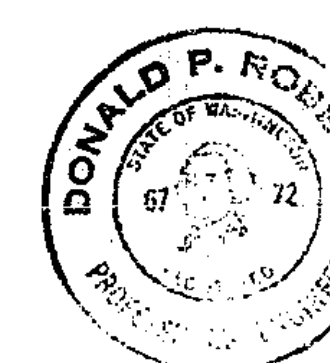


As	Asbuilt; by pass pipe alignment	WJW	1/1/69		
RI	18" dia migrant by-pass pipe realigned	4/14/67	SJ 2/15/67		
NO.	REVISION	ISSUE DATE	BY	APPD	DATE
CITY OF TACOMA DEPARTMENT OF PUBLIC UTILITIES MAJOR PROJECTS DIVISION					
MOSSYROCK PROJECT SALMON HATCHERY - BARRIER DAM GENERAL PLAN FISH LADDERS AND TRANSPORTATION CHANNEL					
HARZA ENGINEERING COMPANY					
DRAWN	ELK	SJ/SAHA	DESIGNED	DPH	
CHECKED	SJ	DPH	REVIEWED	HARZA ENGINEERING COMPANY	
APPROVED FOR CITY OF TACOMA AS TO GENERAL FEATURES					
PROJECT MANAGER					
TACOMA, WASHINGTON					
DATE MAY, 1967					
DRAWING NUMBER MA2788 RL/AS					
SCALE As shown					
DRAWER NO.					

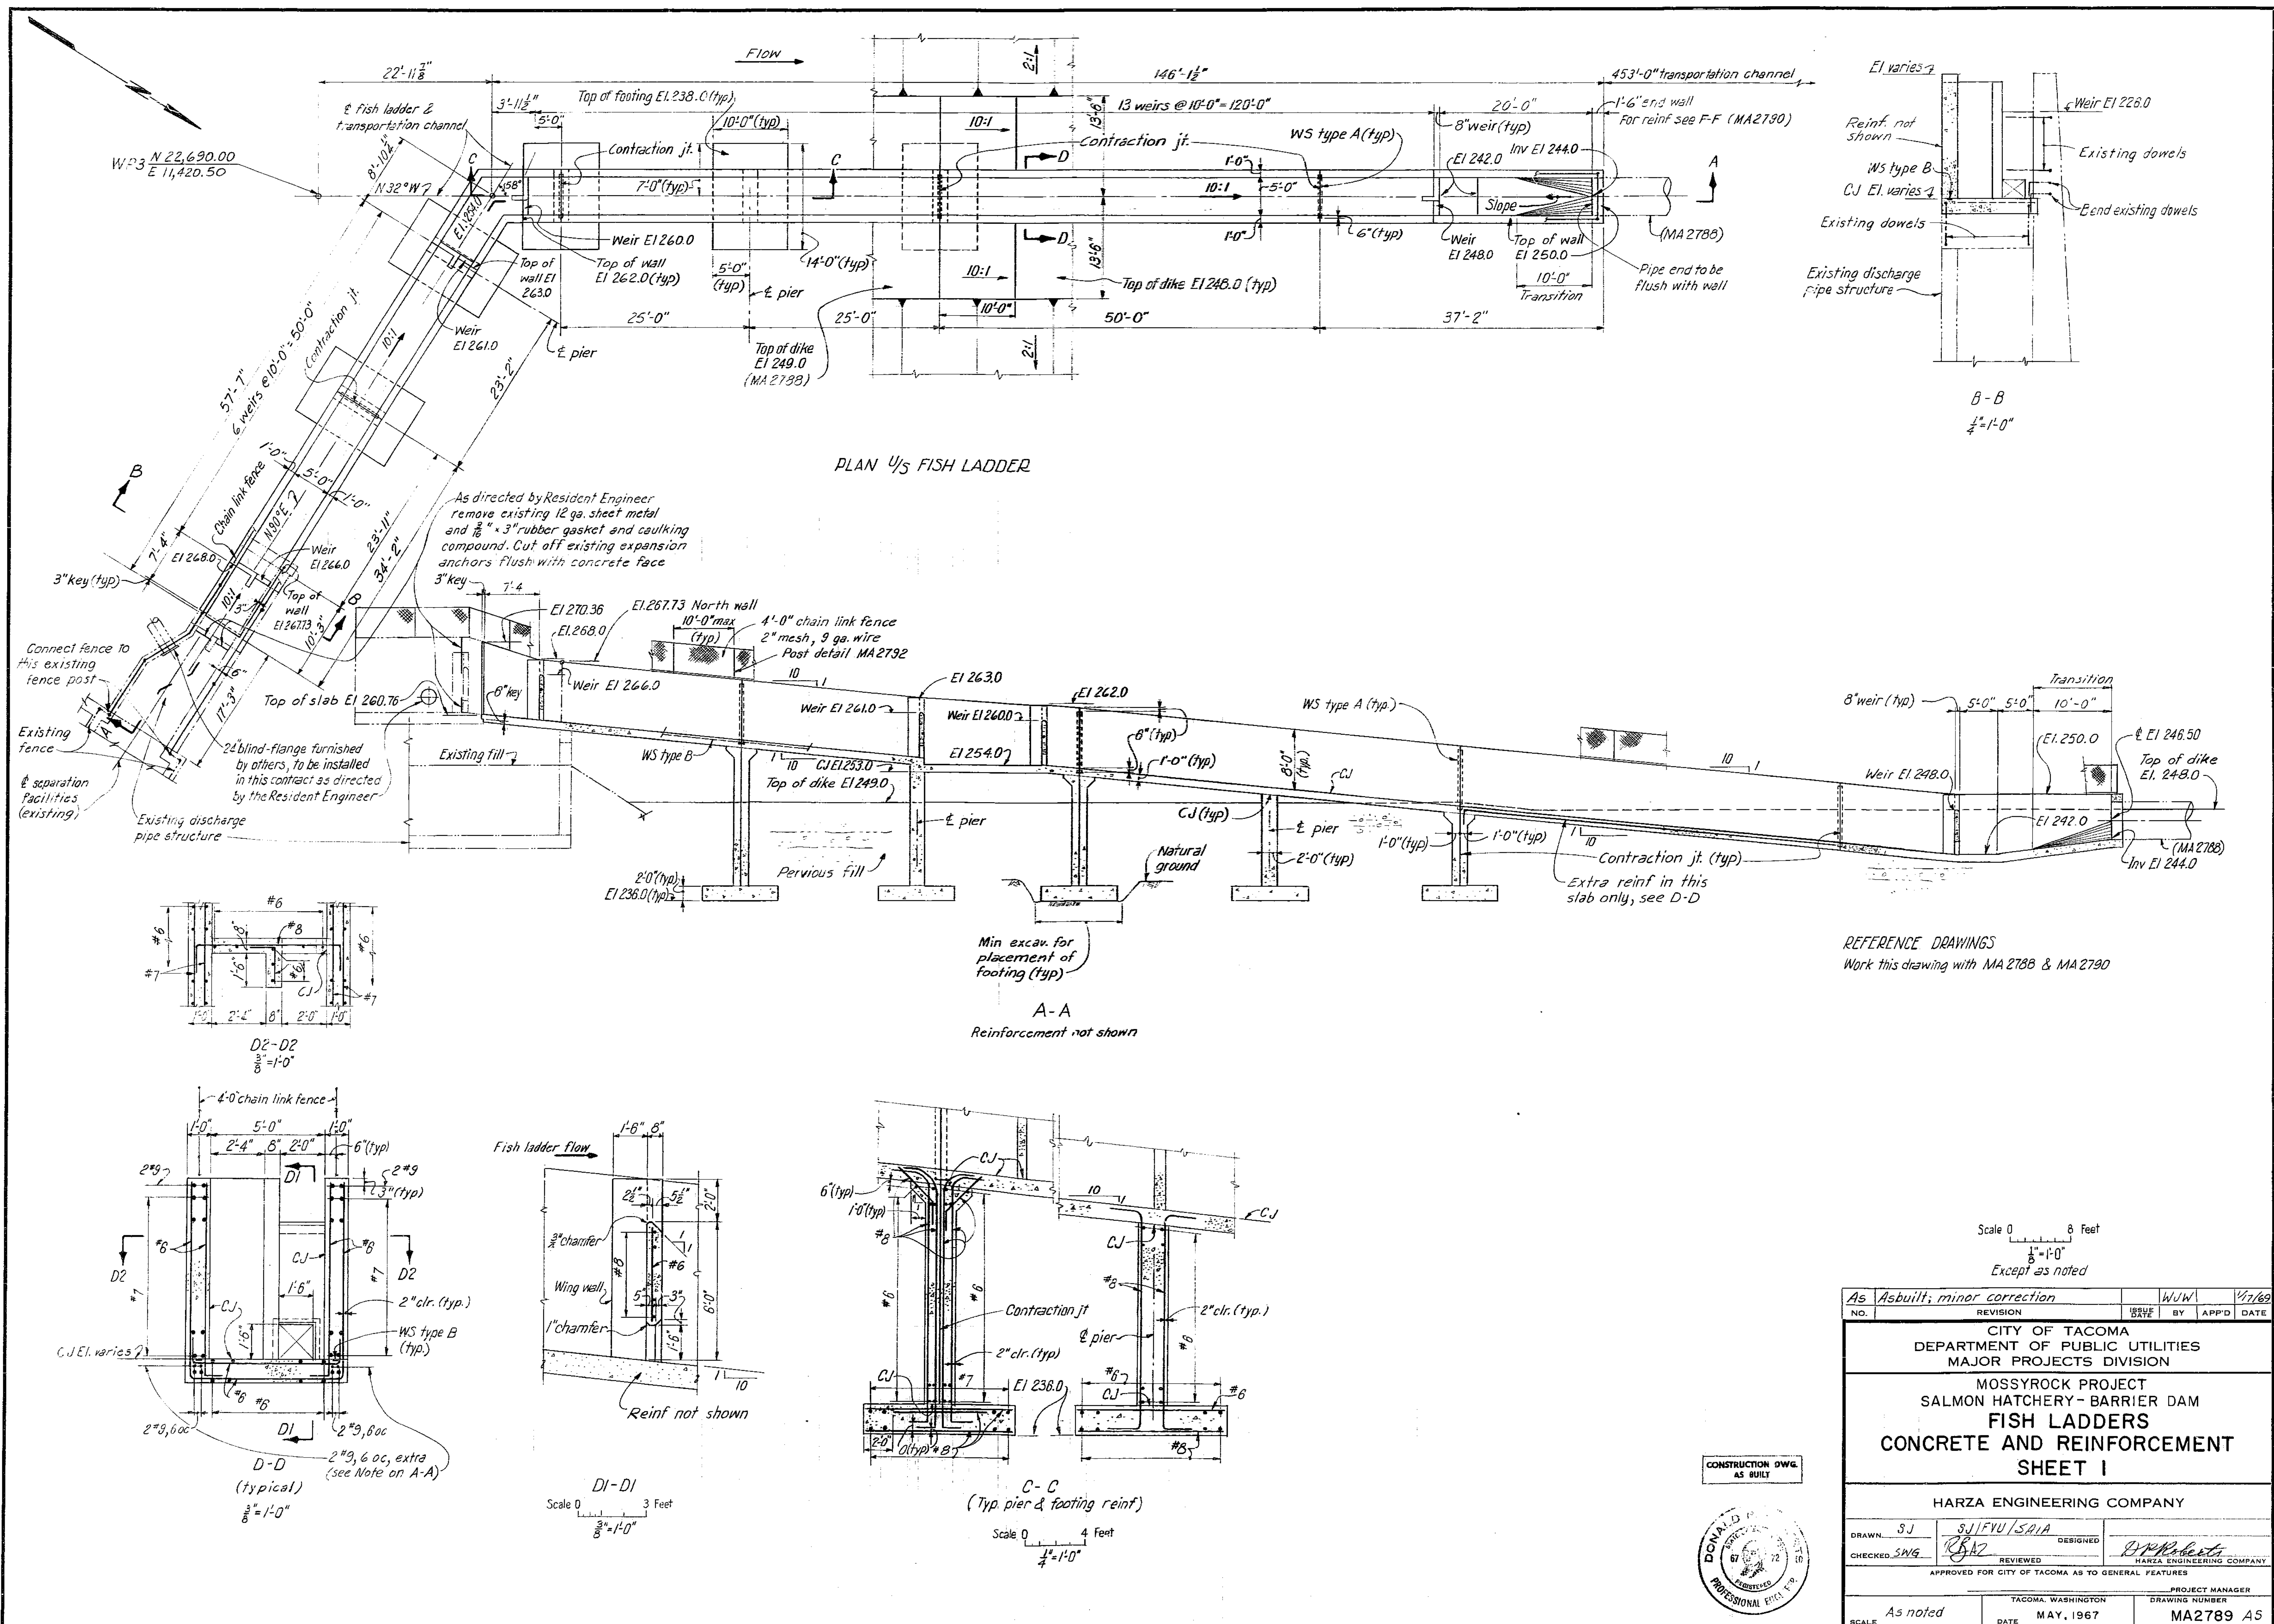


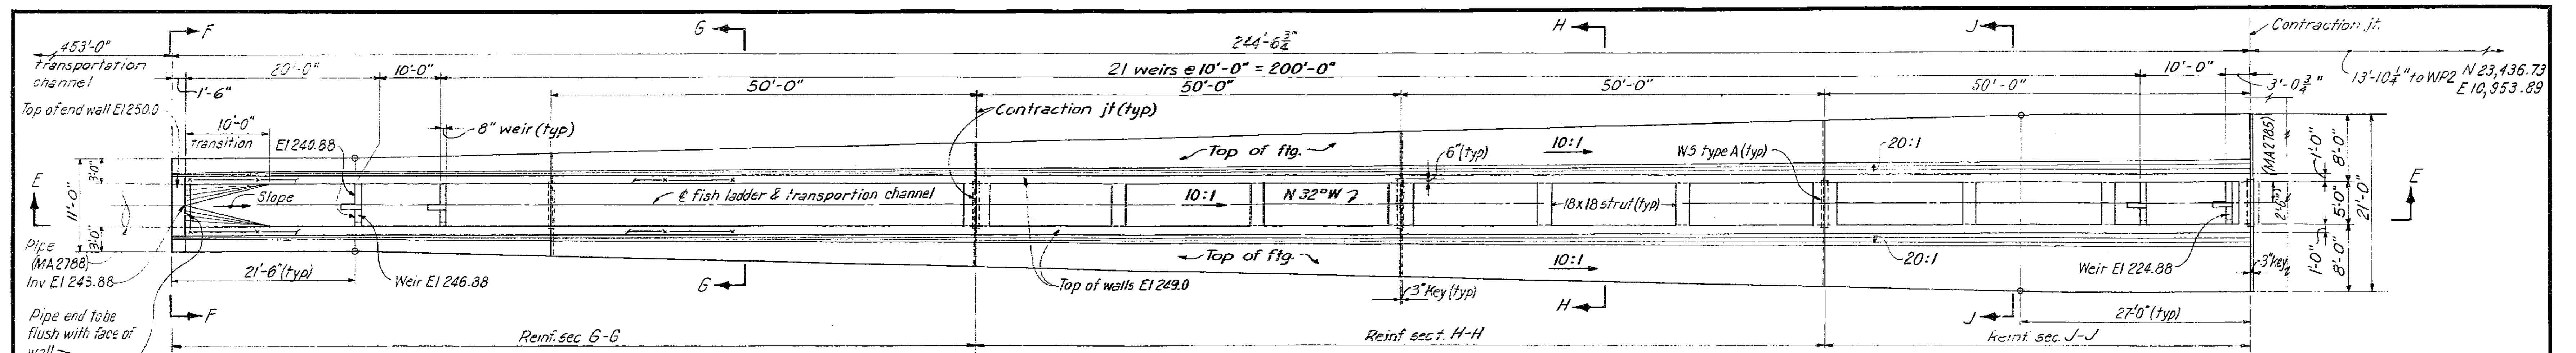


PLAN-DOWNSTREAM FISH LADDER

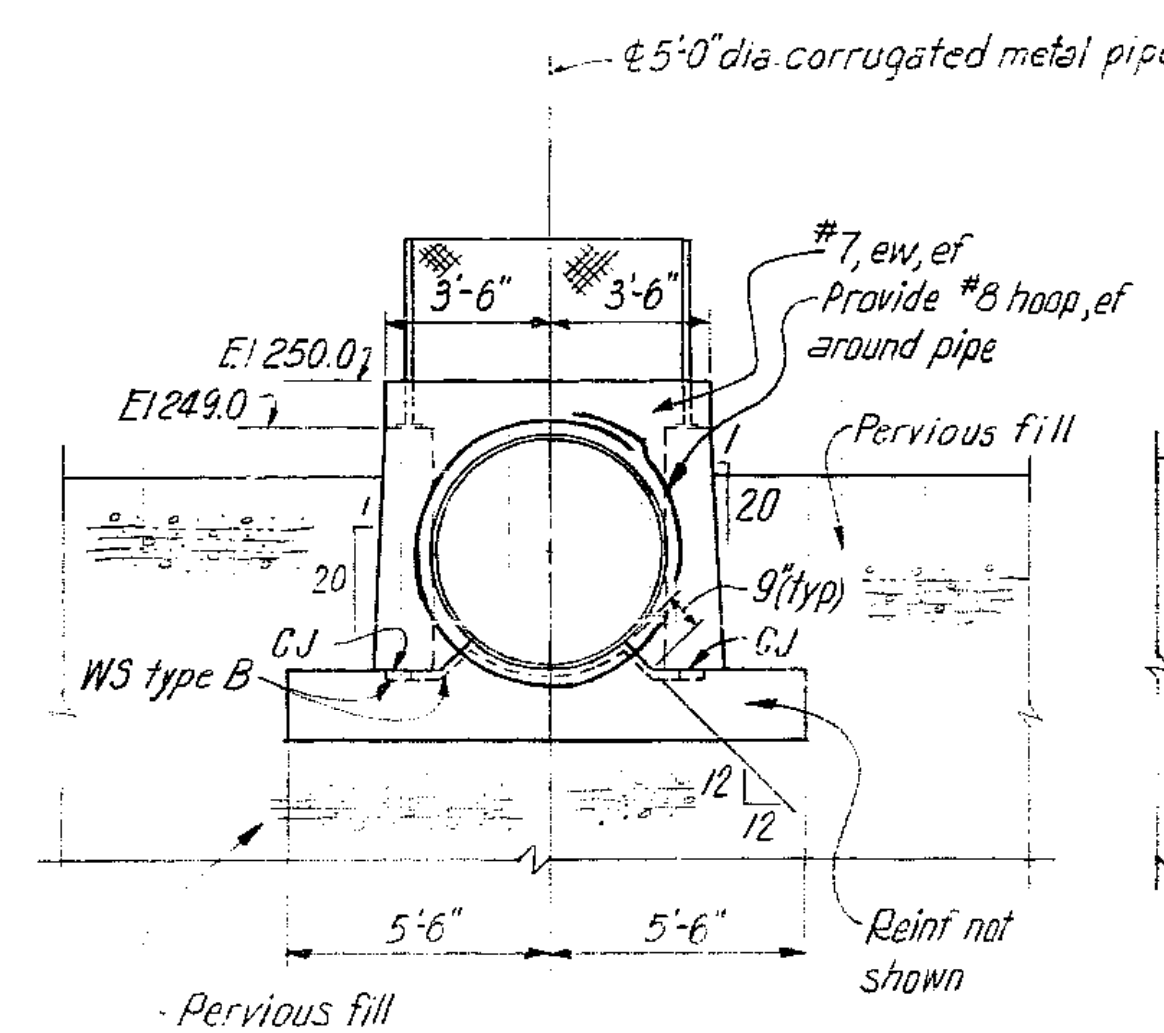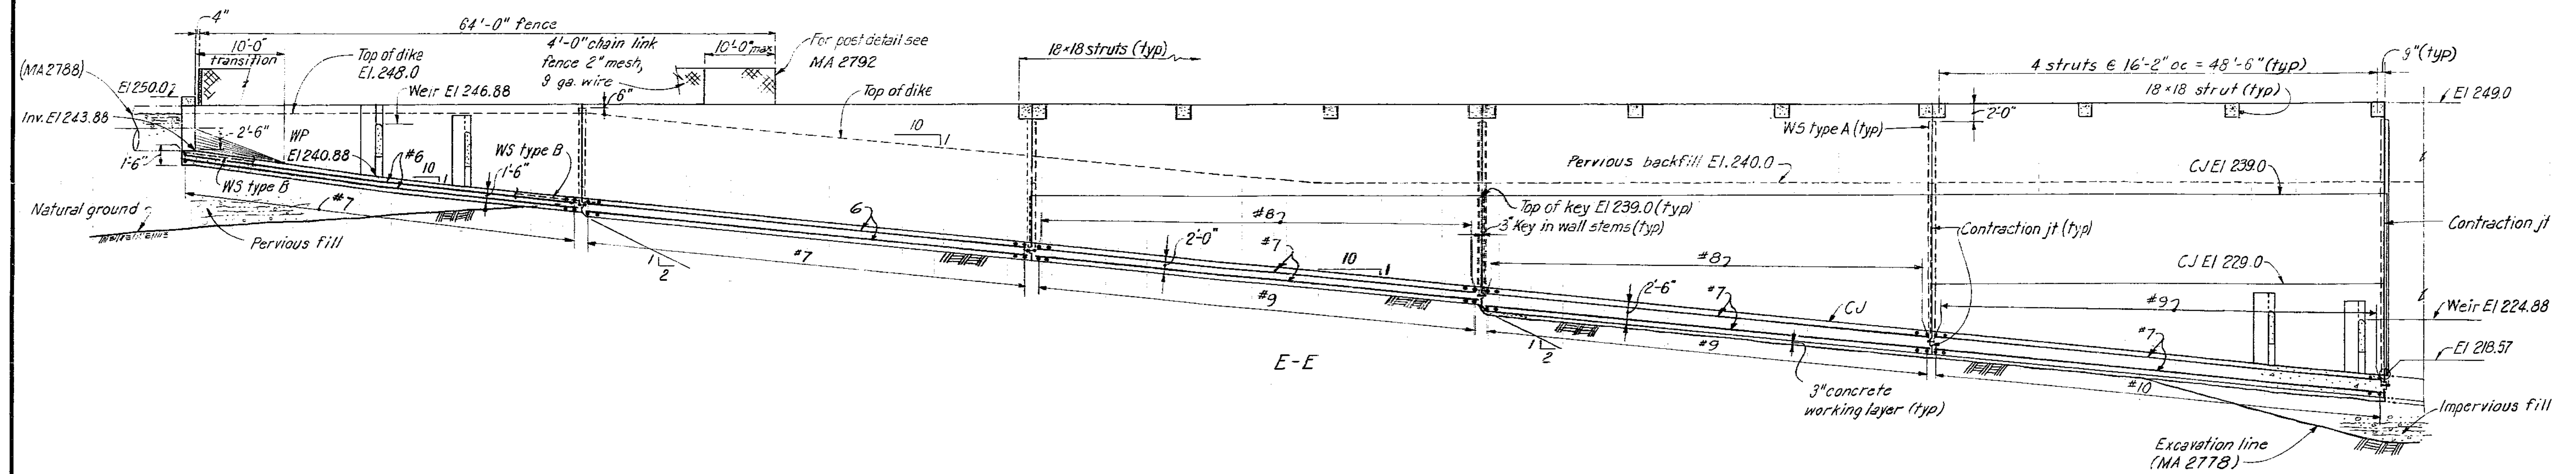


F-F
1/4" = 1'-0"

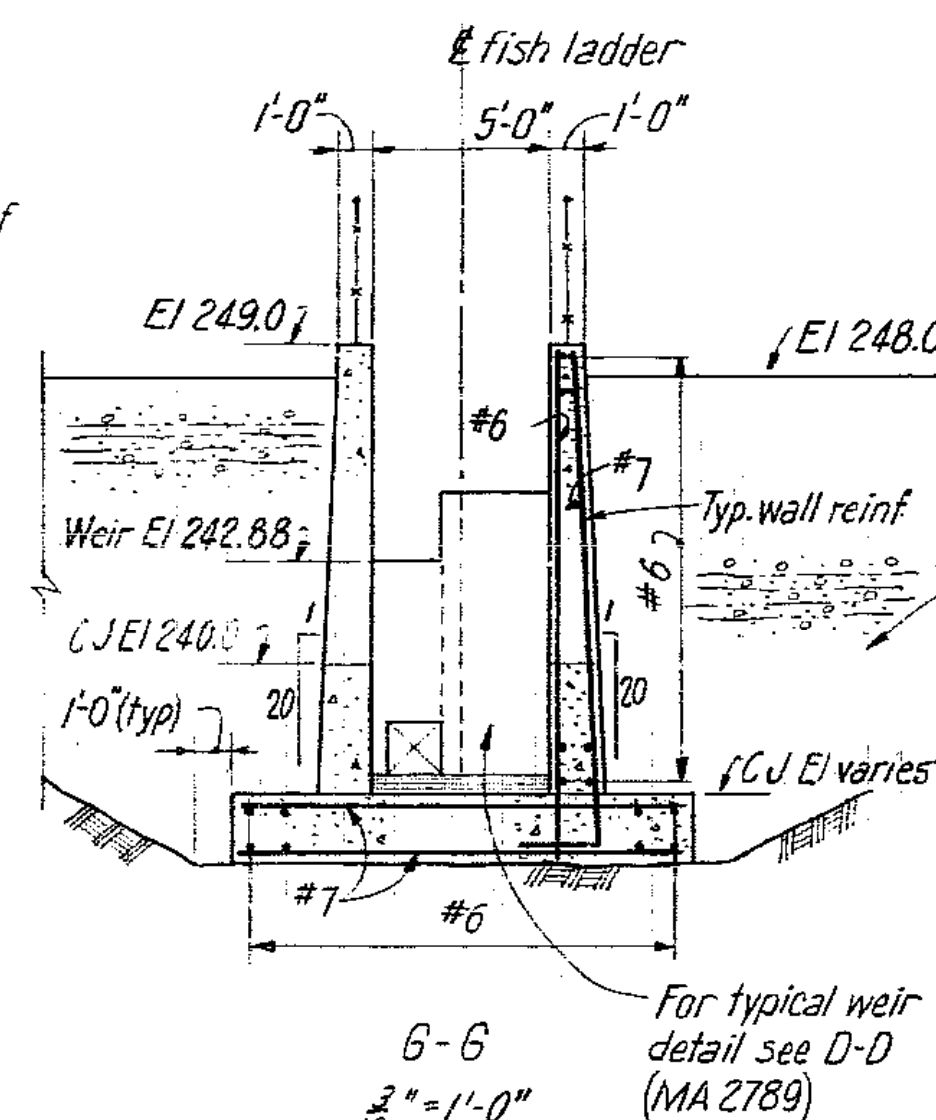

G-G
3/16" = 1'-0"

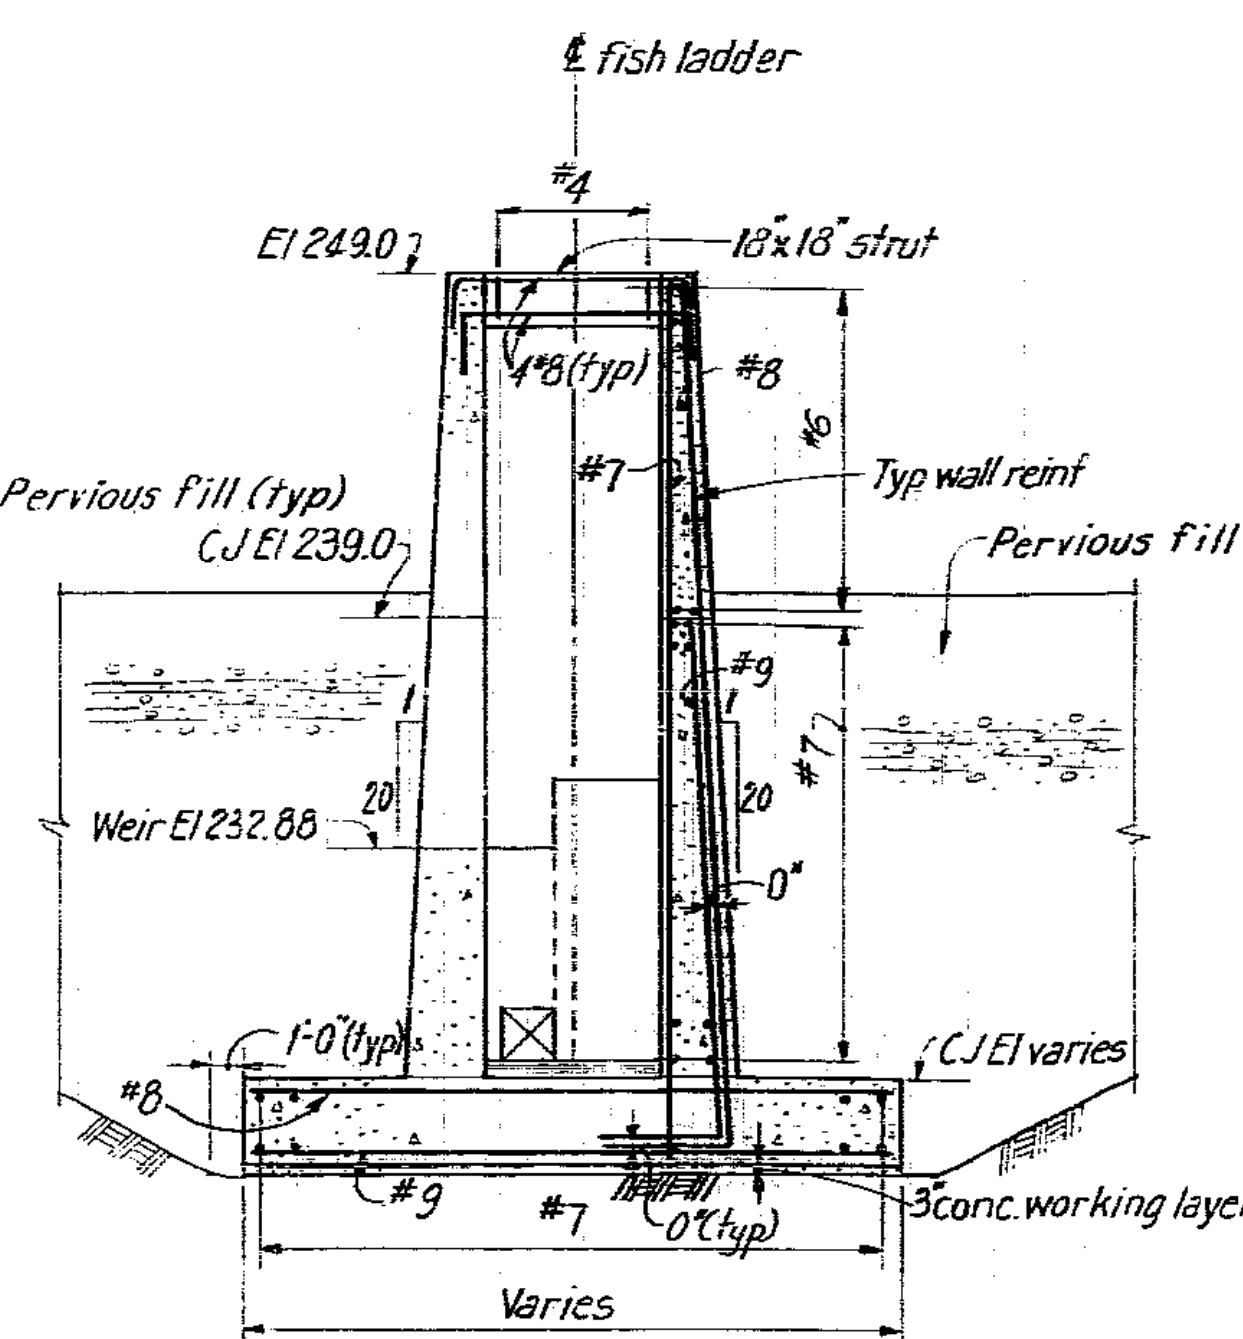

H-H
3/16" = 1'-0"

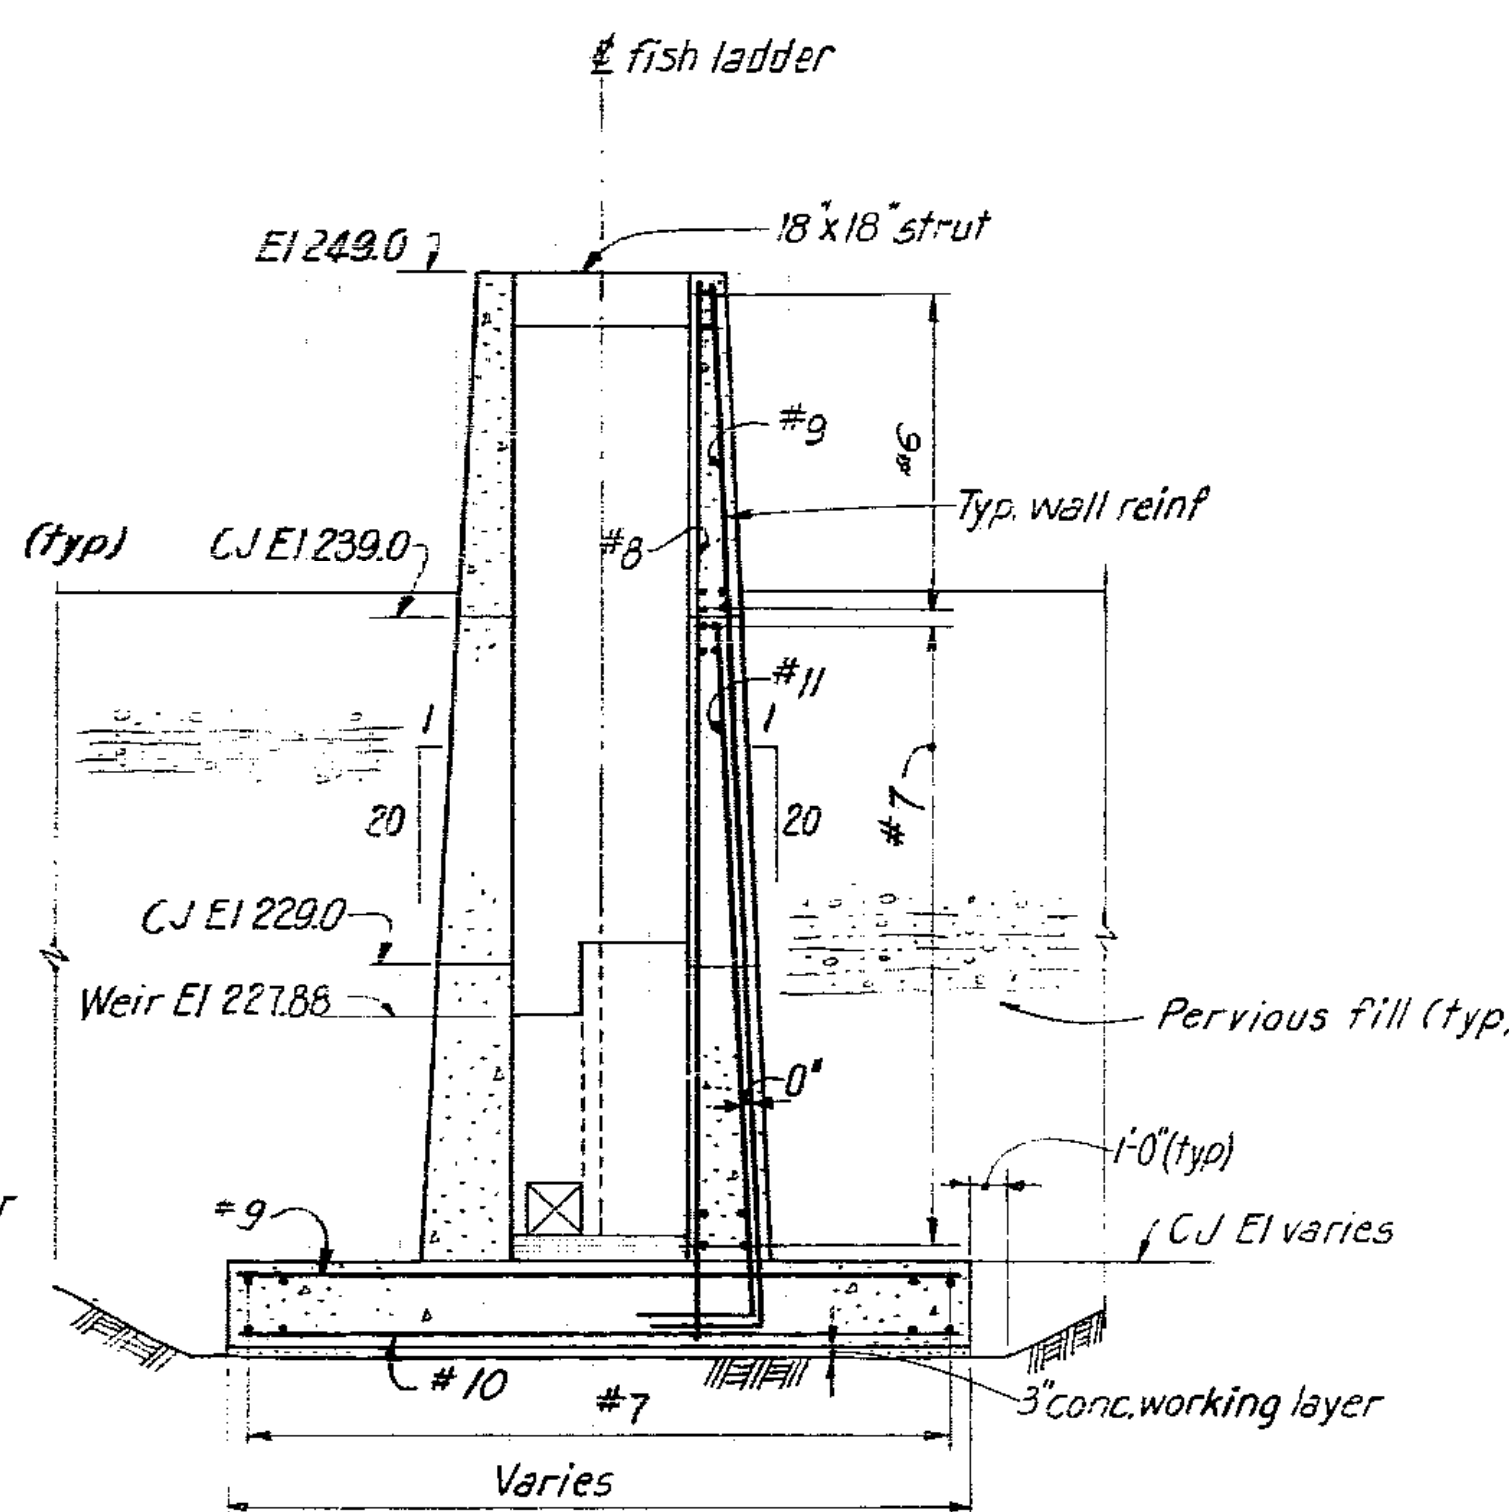


J-J
3/16" = 1'-0"







REFERENCE DRAWINGS:
Work this drawing with MA 2788 & MA 2789

Scale 0 8 16 Feet
3/8" = 1'-0"

As	No Asbuilt Revisions	WJW	1/7/69
1	Added keys - Gen Revisions	9/14/67	9/14/67
NO.	REVISION	DATE	BY
CITY OF TACOMA DEPARTMENT OF PUBLIC UTILITIES MAJOR PROJECTS DIVISION			
MOSSY ROCK PROJECT SALMON HATCHERY - BARRIER DAM FISH LADDERS CONCRETE AND REINFORCEMENT SHEET 2			
HARZA ENGINEERING COMPANY			
DRAWN: S.J. ELK	DESIGNED: S.J. ELK	HARZA ENGINEERING COMPANY	
CHECKED: SWG	REVIEWED: S.J. ELK	APPROVED FOR CITY OF TACOMA AS TO GENERAL FEATURES	
TACOMA, WASHINGTON		PROJECT MANAGER	
SCALE: As noted		DRAWING NUMBER: MA2790R1/AS	
DATE: MAY, 1967			


CONSTRUCTION DWG.
AS BUILT

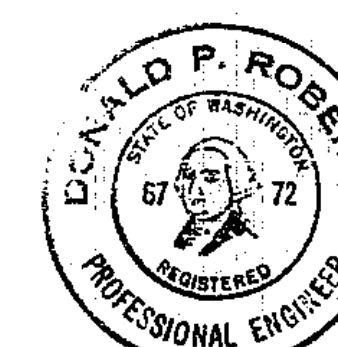


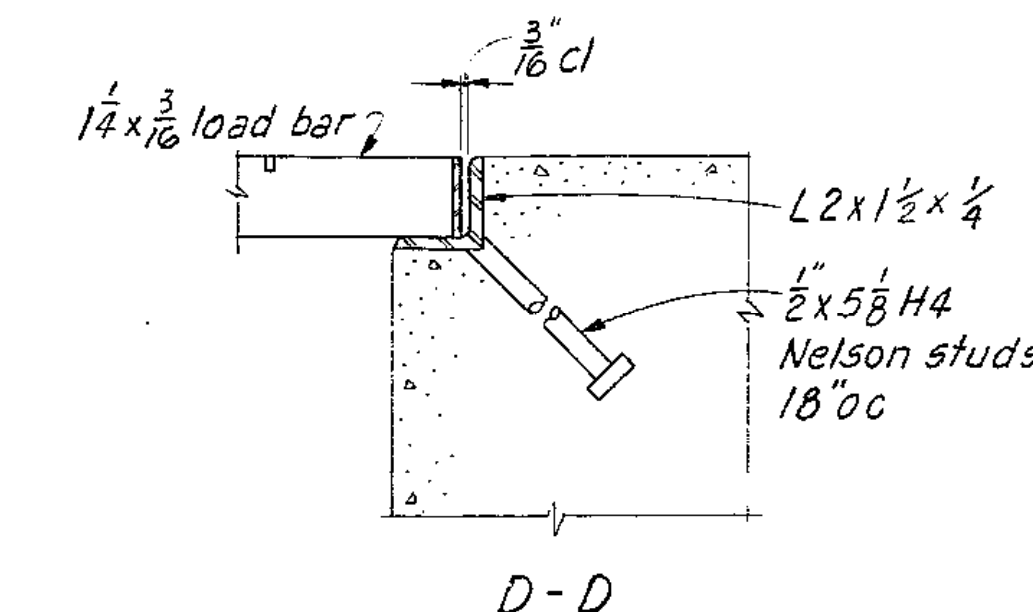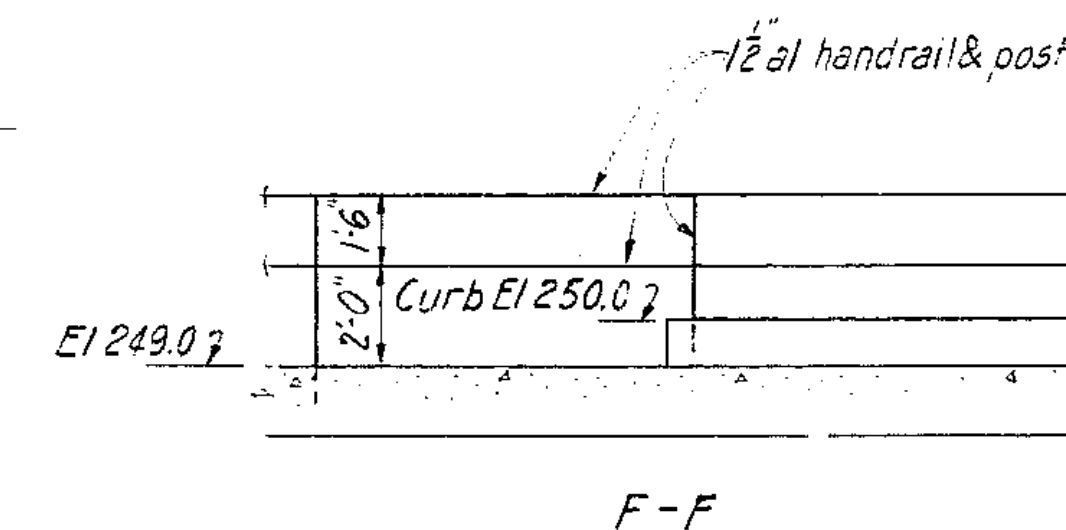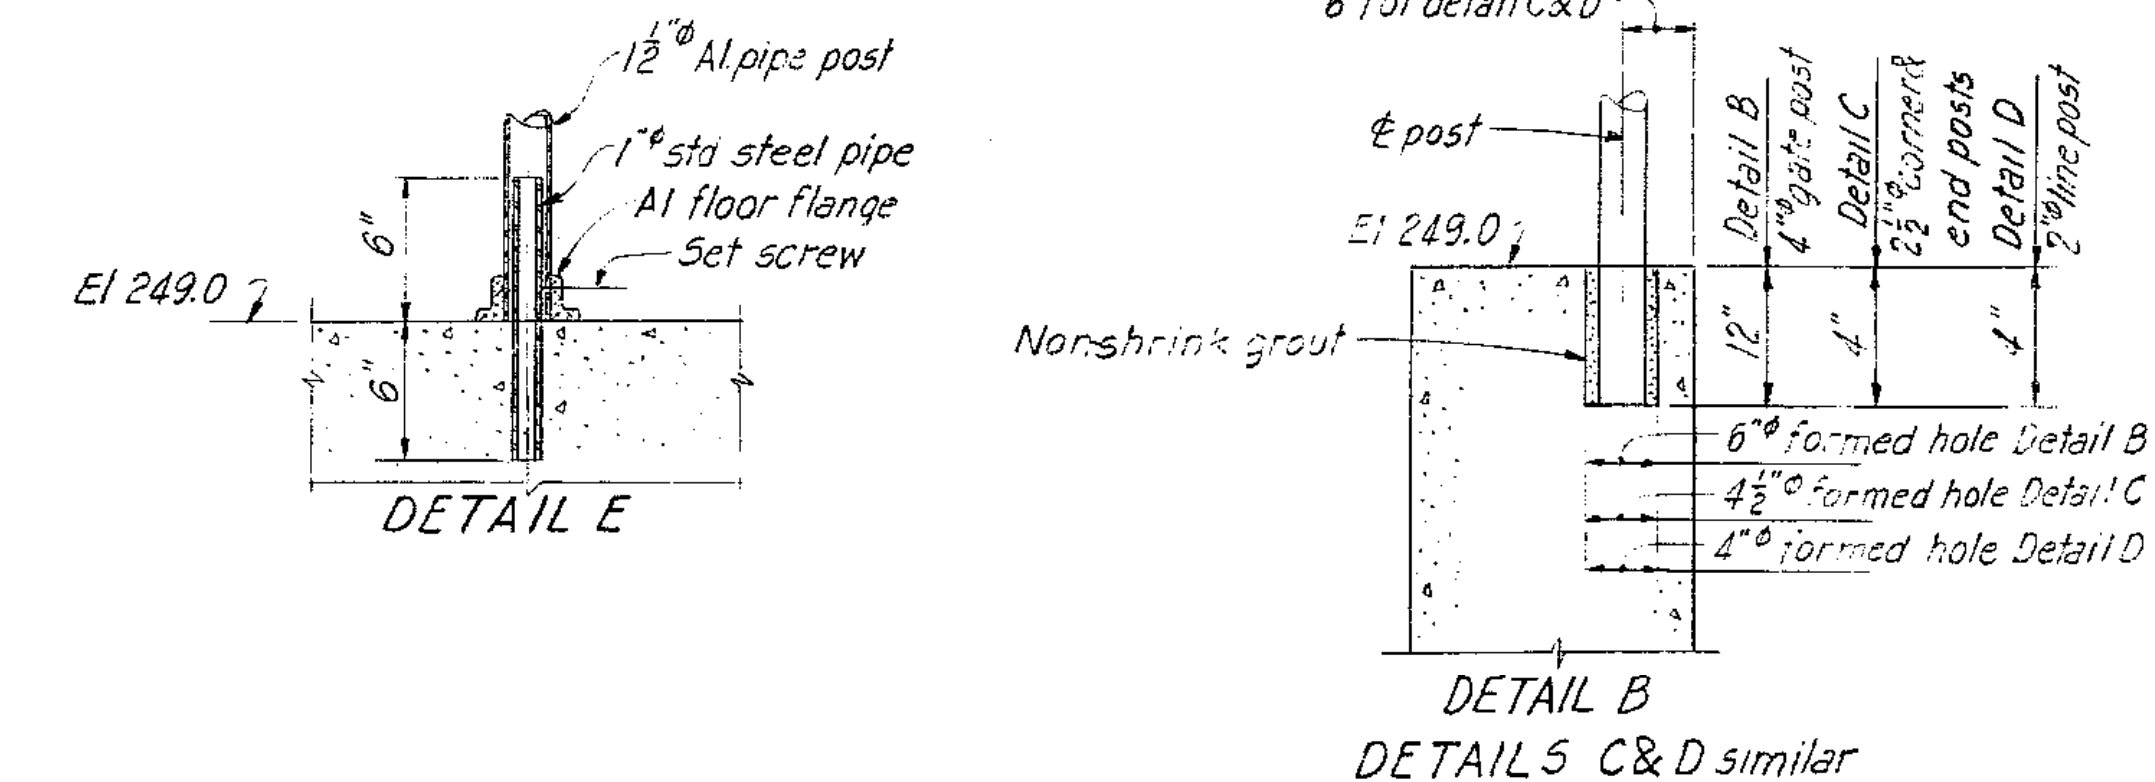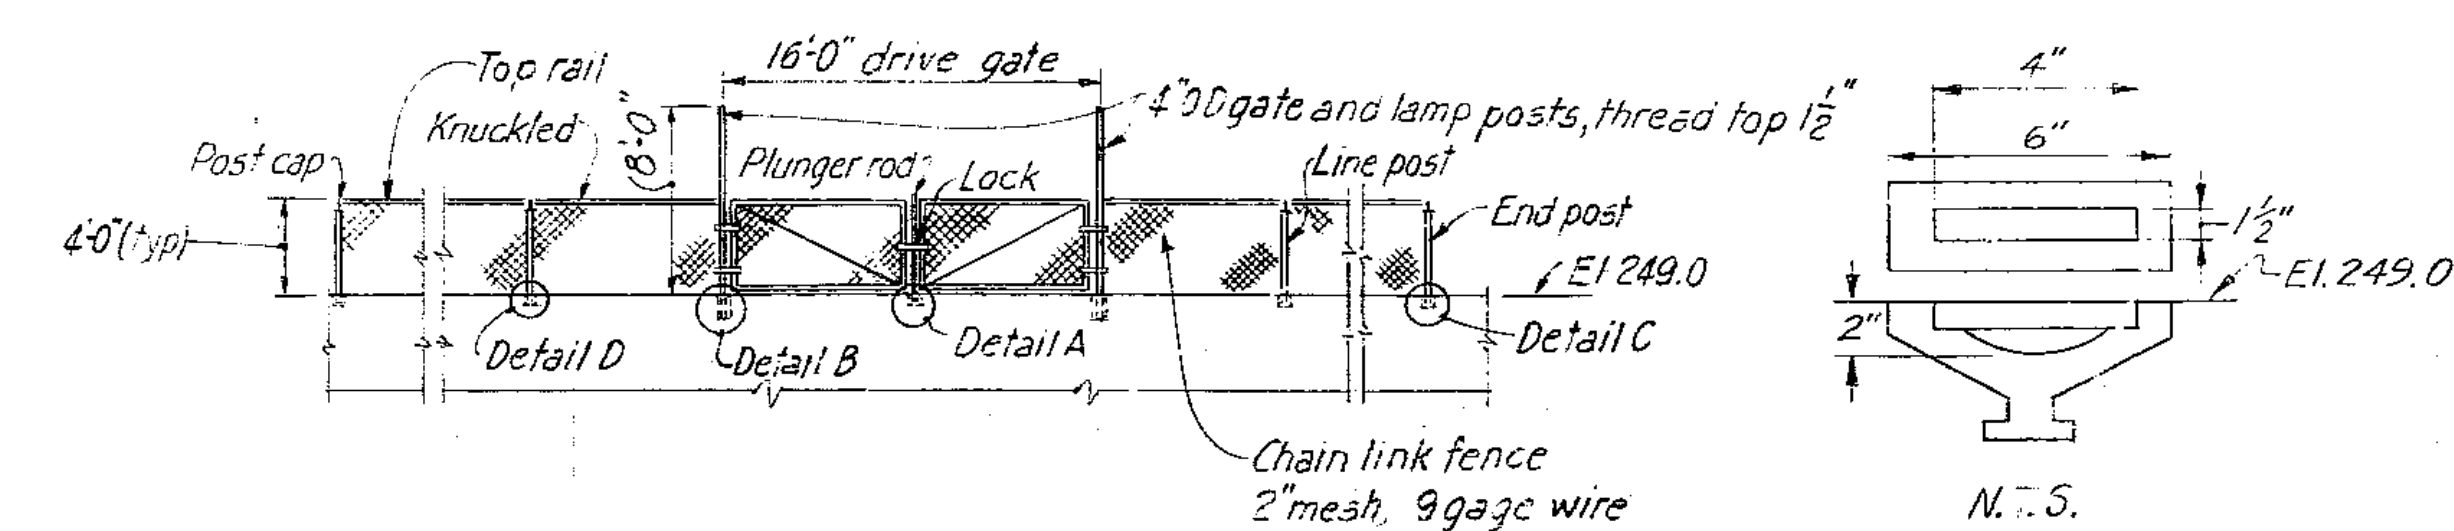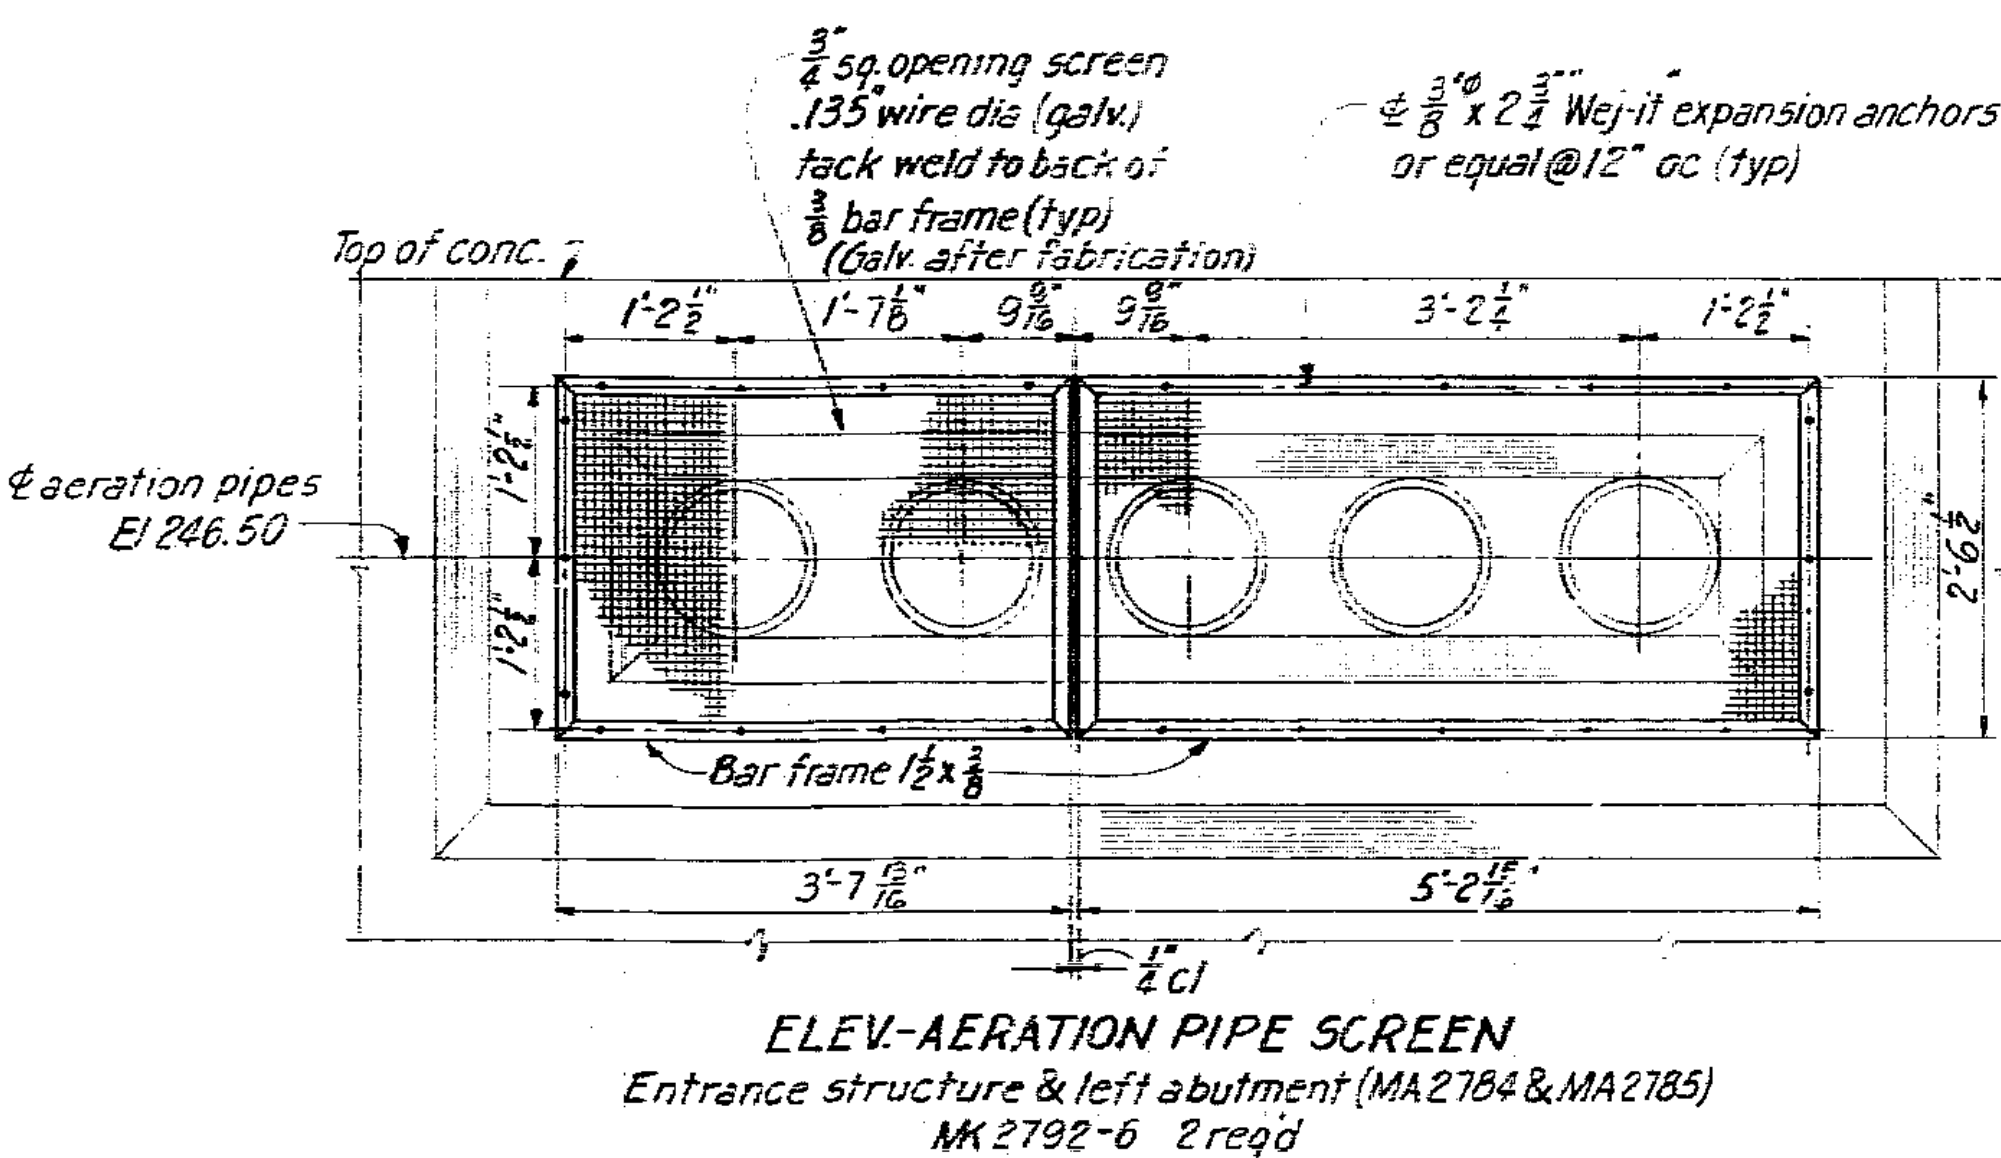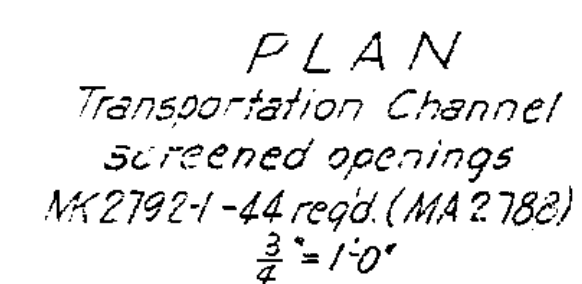


REFERENCE DRAWINGS:
Concrete MA2784, MA2785, MA2788
Standard Details MA2775, MA2776

As	Asbuilt; minor revisions			WJW	20%
1	Revised A-A, B-B & misc.		4/14/77	ELK	4/16
NO.	REVISION	ISSUE DATE	BY	APP'D	DA
CITY OF TACOMA DEPARTMENT OF PUBLIC UTILITIES MAJOR PROJECTS DIVISION					
MOSSYROCK PROJECT SALMON HATCHERY - BARRIER DAM MISCELLANEOUS METALS SHEET I					
HARZA ENGINEERING COMPANY					
DRAWN	ELK	ELK/SAIA	DESIGNED		
CHECKED	FVU	CSA2	REVIEWED	HARZA ENGINEERING COMPANY	
APPROVED FOR CITY OF TACOMA AS TO GENERAL FEATURES					
TACOMA, WASHINGTON			DRAWING NUMBER		
DATE MAY, 1967			MA2792R1/A		
As noted					

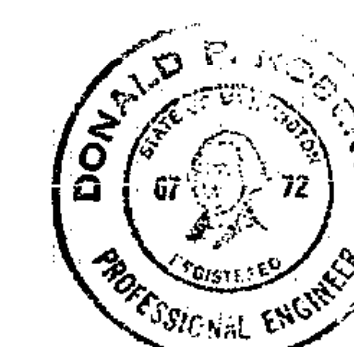


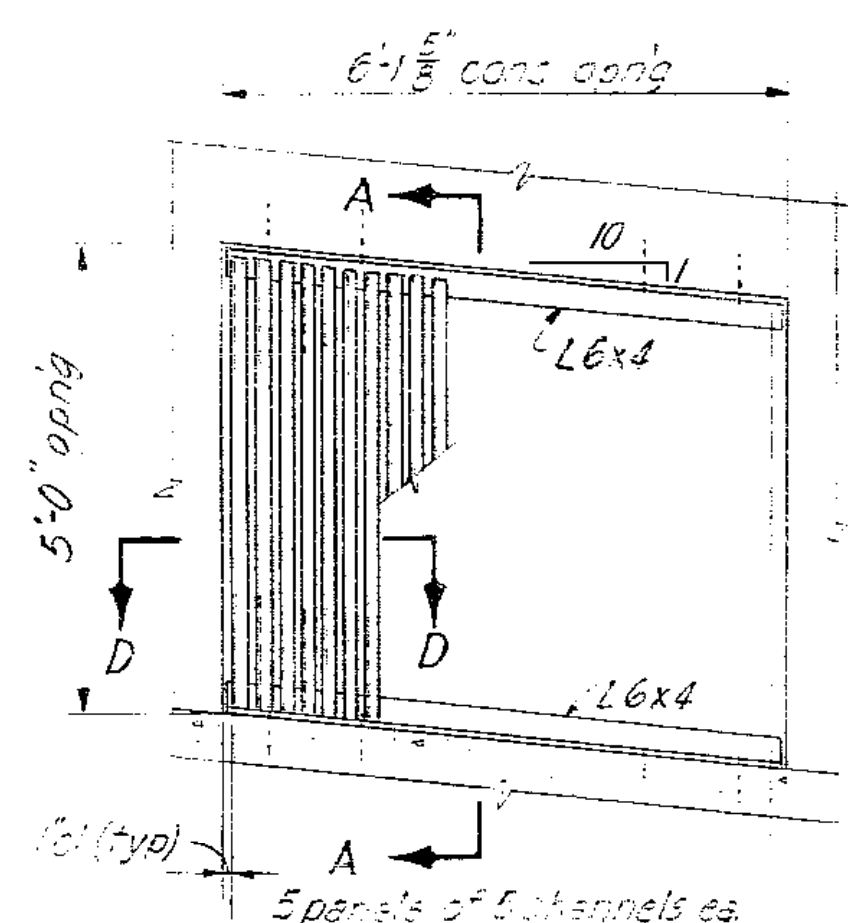


ELEV-DIFFUSION GRATING (MA2785)
MK 2793-1 2 req'd

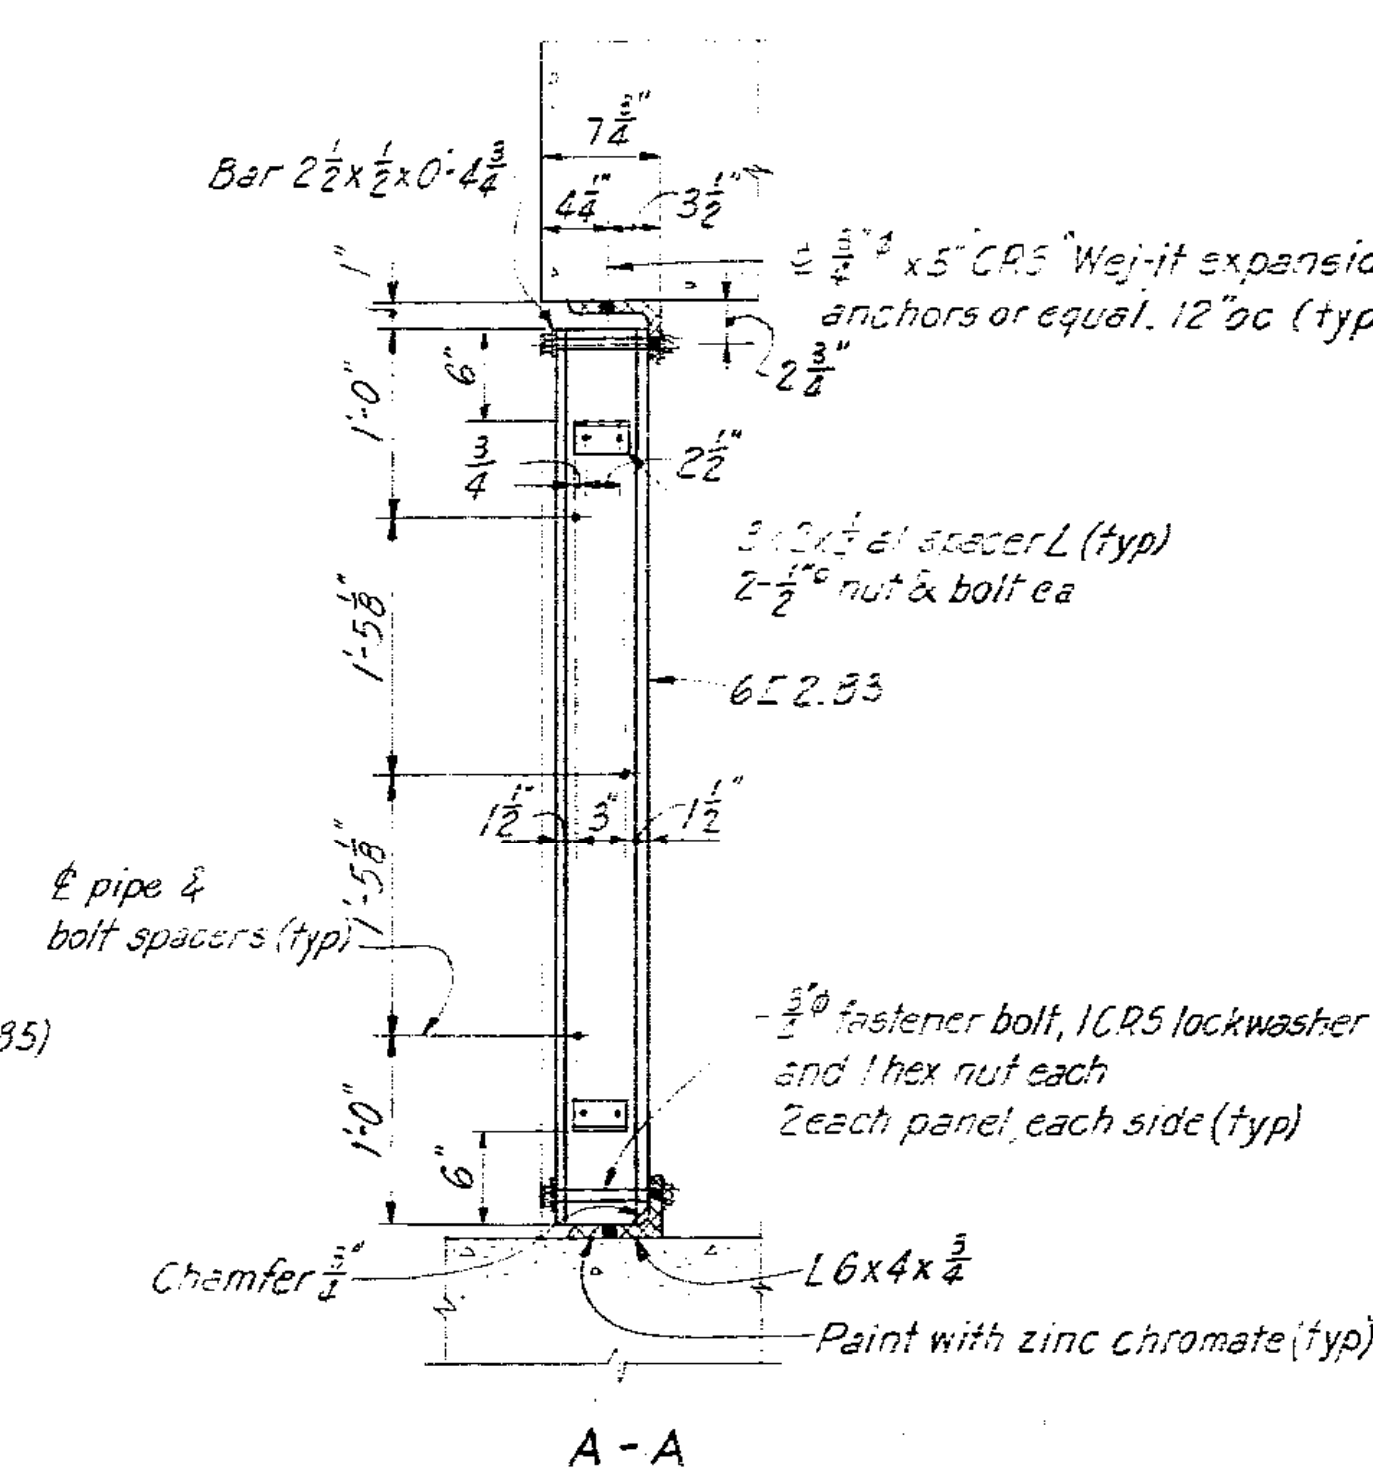


A-A

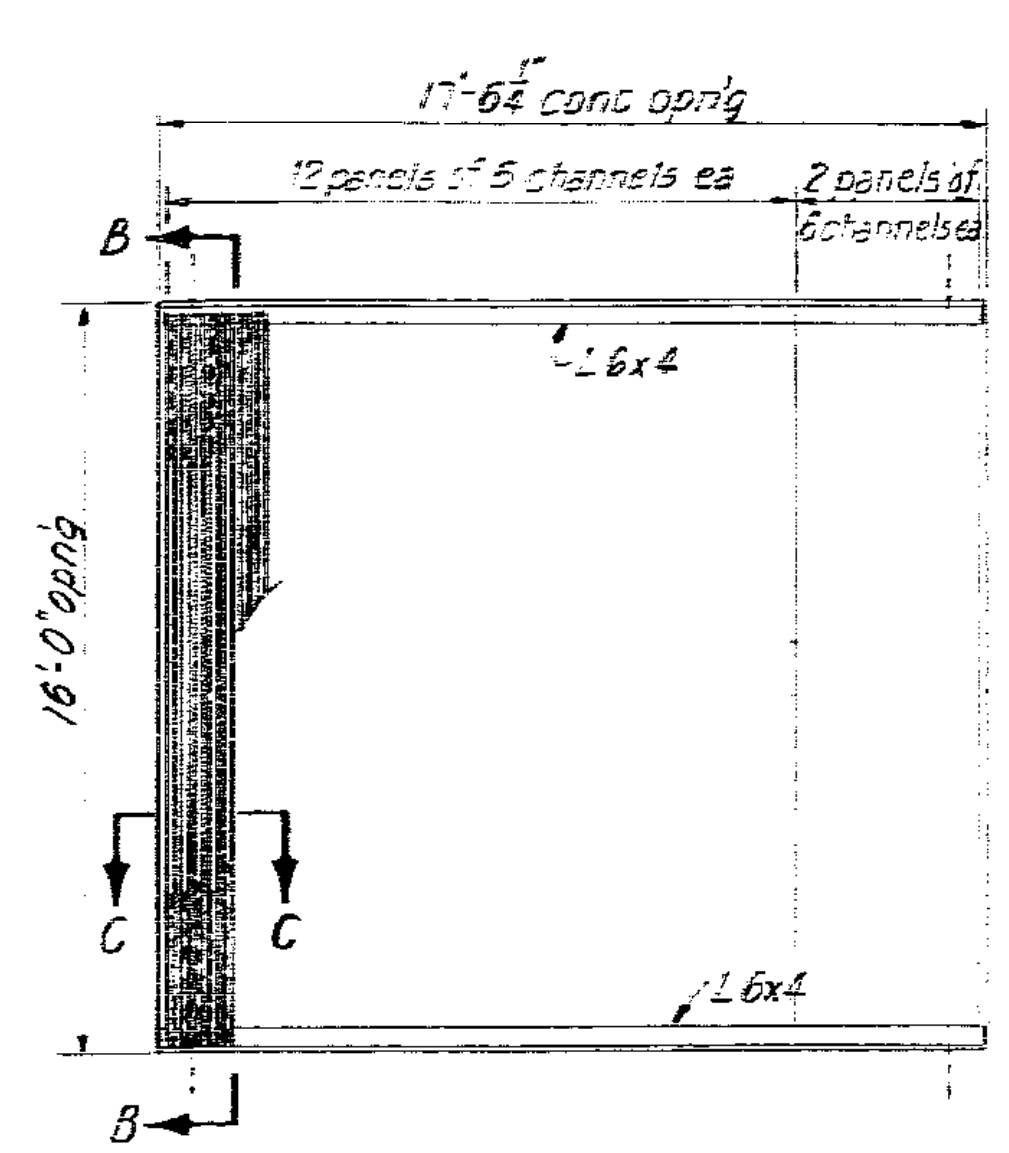


ELEV-DIFFUSION GRATING (MA2785)
MK 2793-2 2 req'd

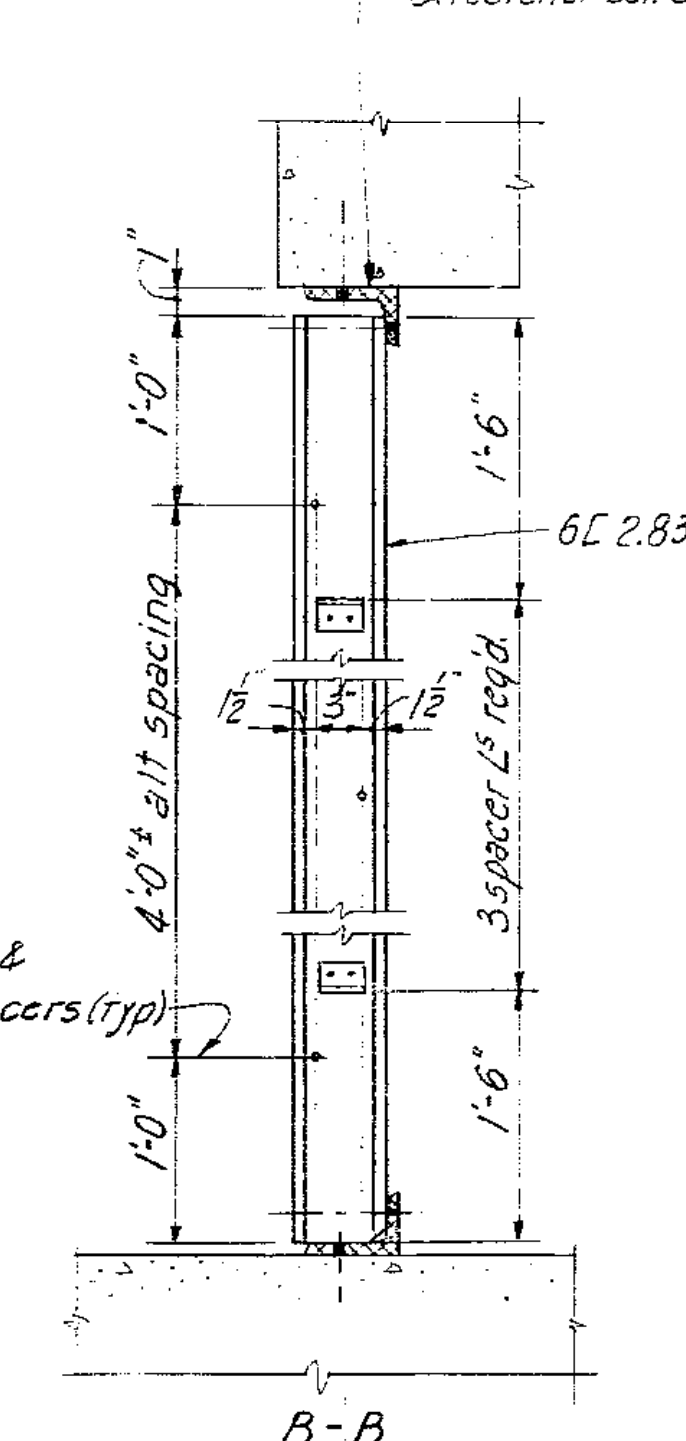


B-B

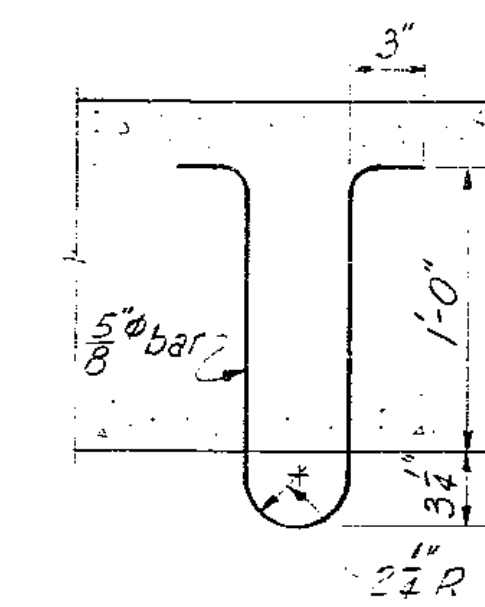


PULL EYE FOR ELECTRIC CABLES
MK 2793-3 4 req'd

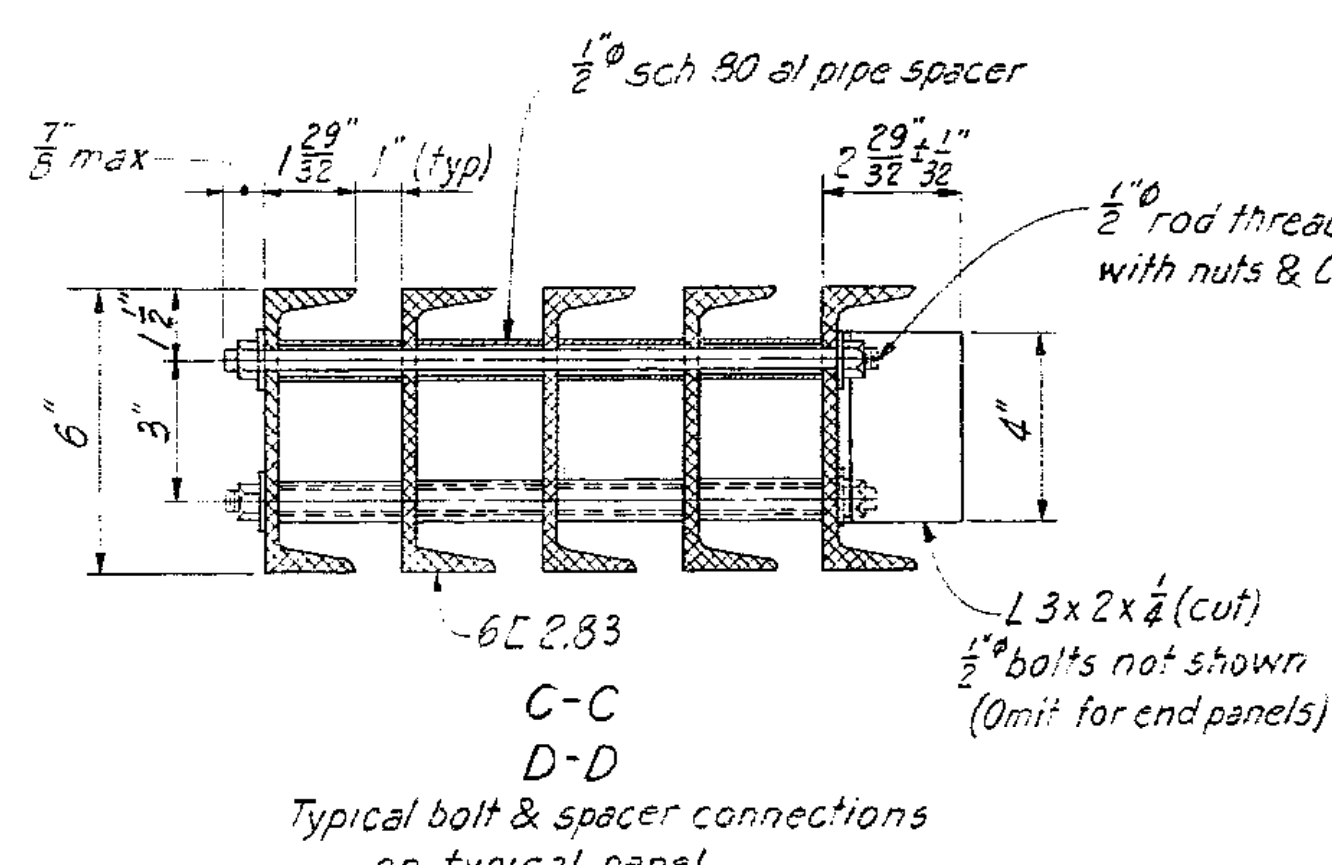


Typical bolt & spacer connections
on typical panel

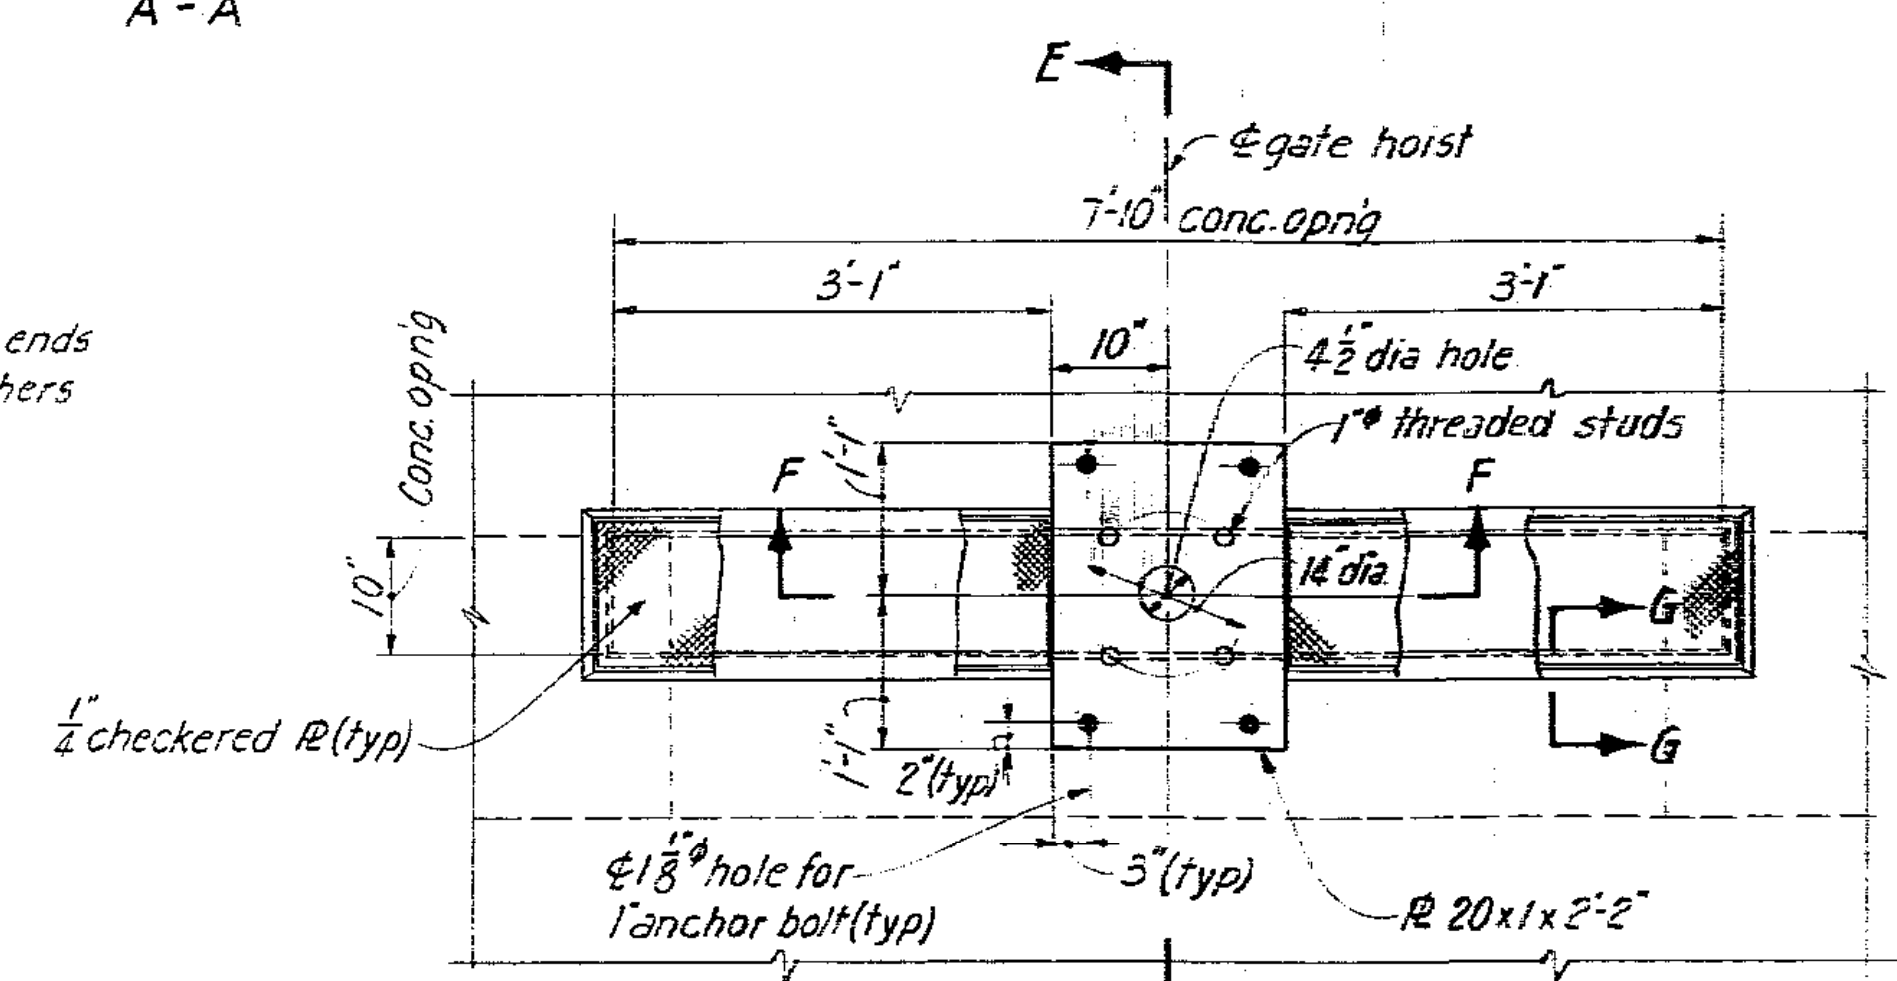

PLAN-GRAVITY INTAKE GATE HOIST MOUNTING R & FRAME & COVER
MK 2793-6 1 req'd (MA2785)

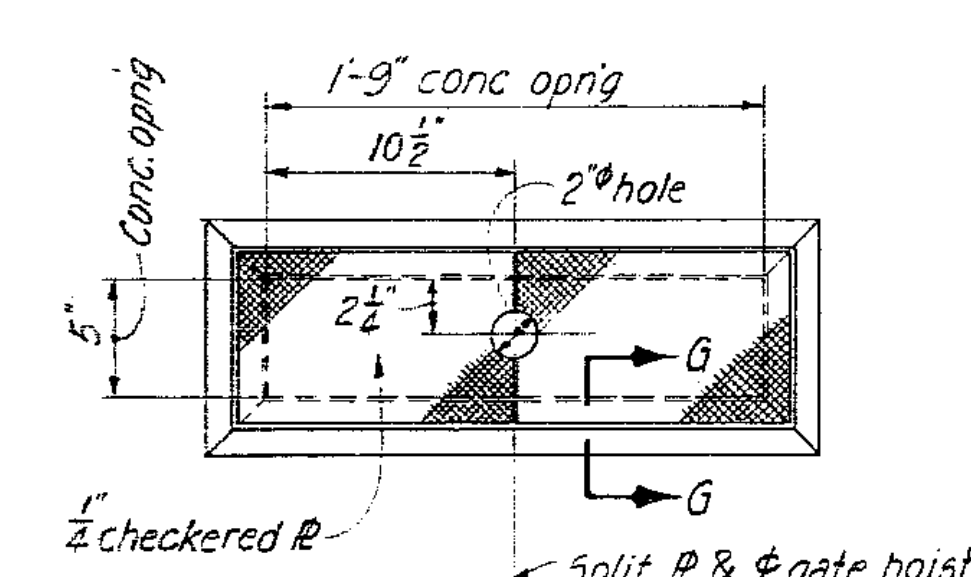


PLAN-RIGHT BANK AUXILIARY ENTRANCE
FRAME & COVER
MK 2793-7 1 req'd (MA2785)

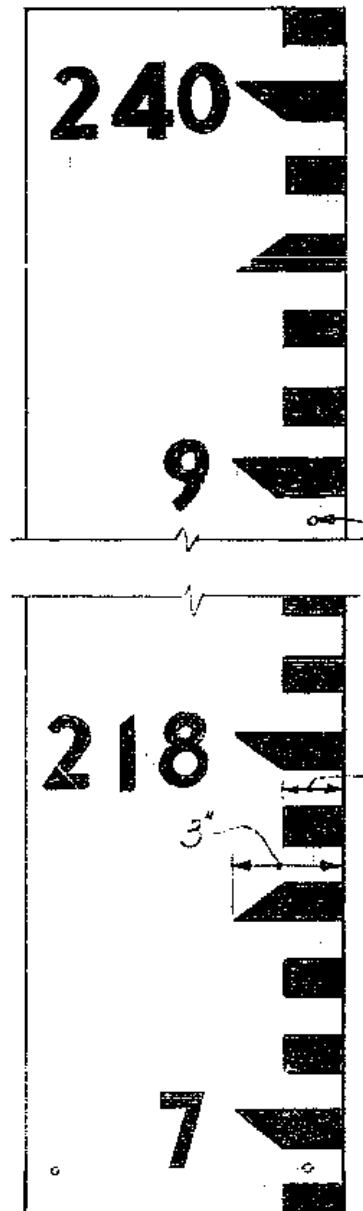


STAFF GAGE (MA2765)
Top and bottom typical foot shown (MK 2793-4)
MK 2793-5 similar see table below

Mark No	Elev range (in feet)	No req'd	Location
2793-4	217 - 240	3	Entrance structure
2793-5	229 - 246	1	Entrance structure


NOTE: Gage material to be No. 8 ga. steel
porcelain enameled with
black numerals on white
background.
Full numbers at each
even elevation

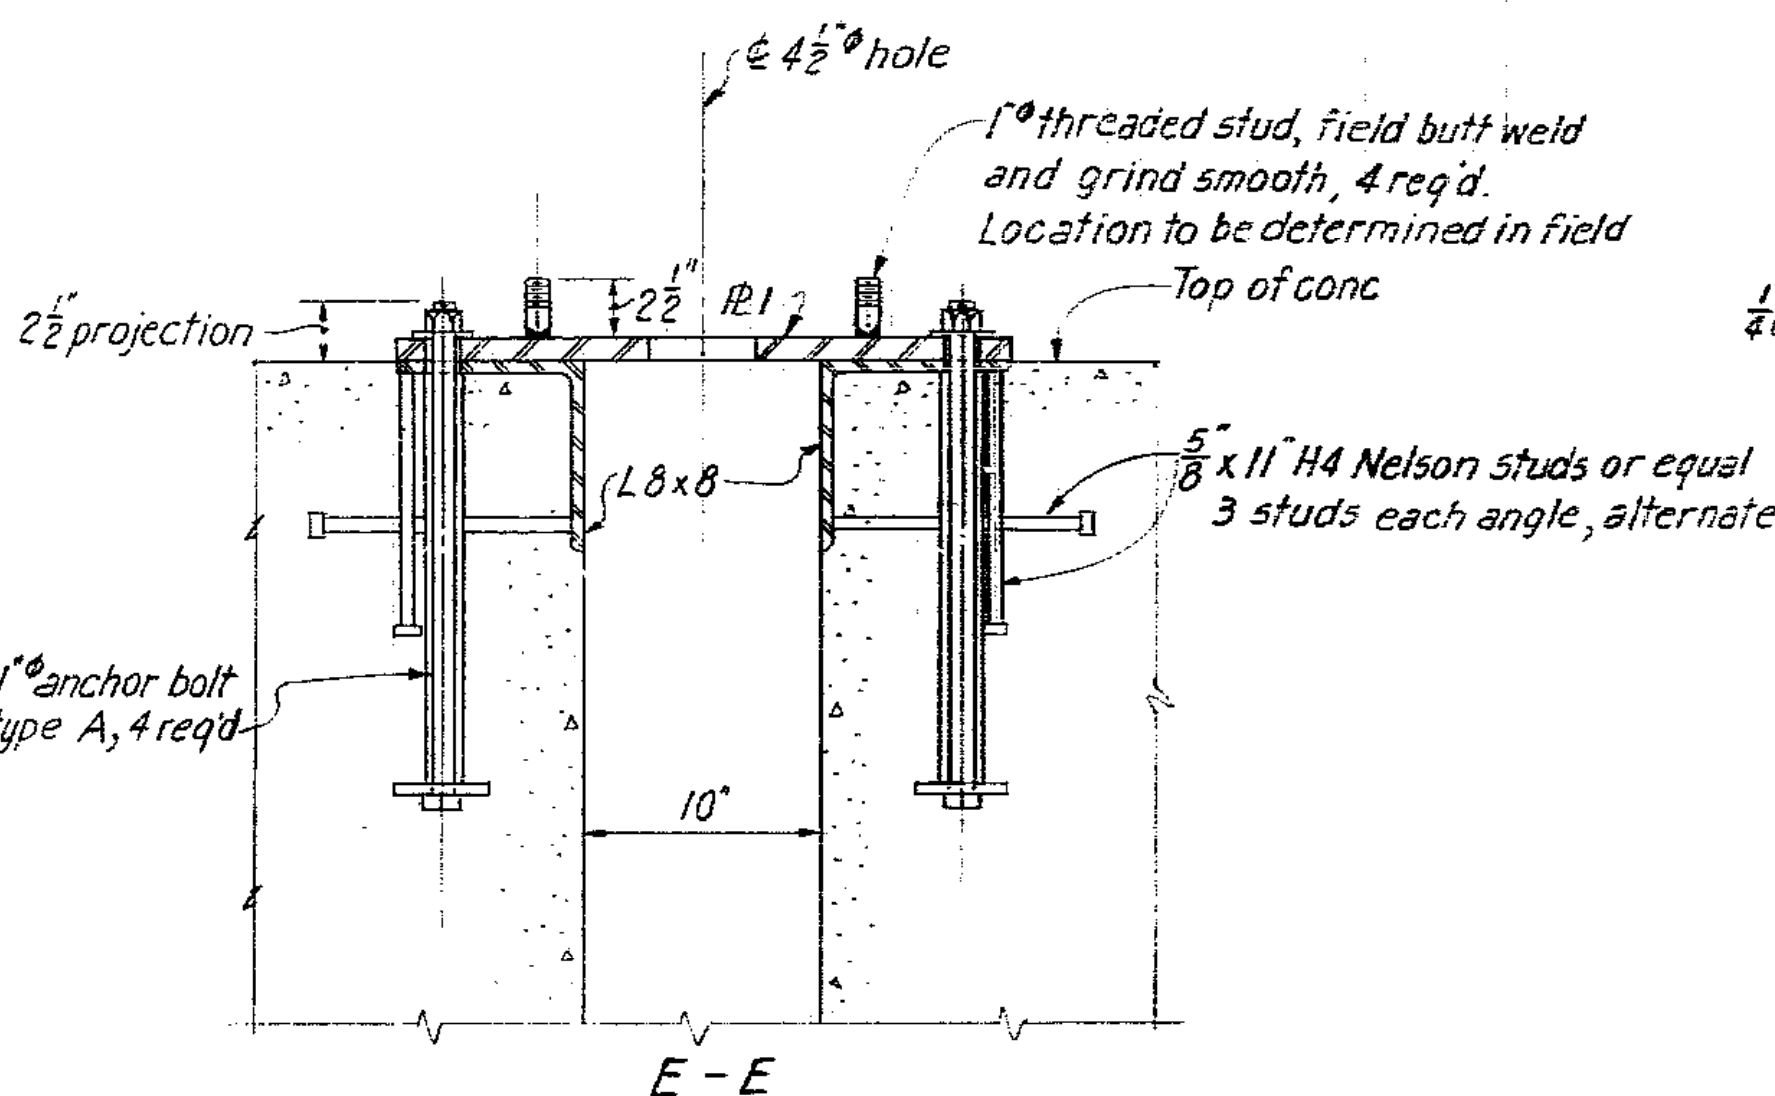


E-E

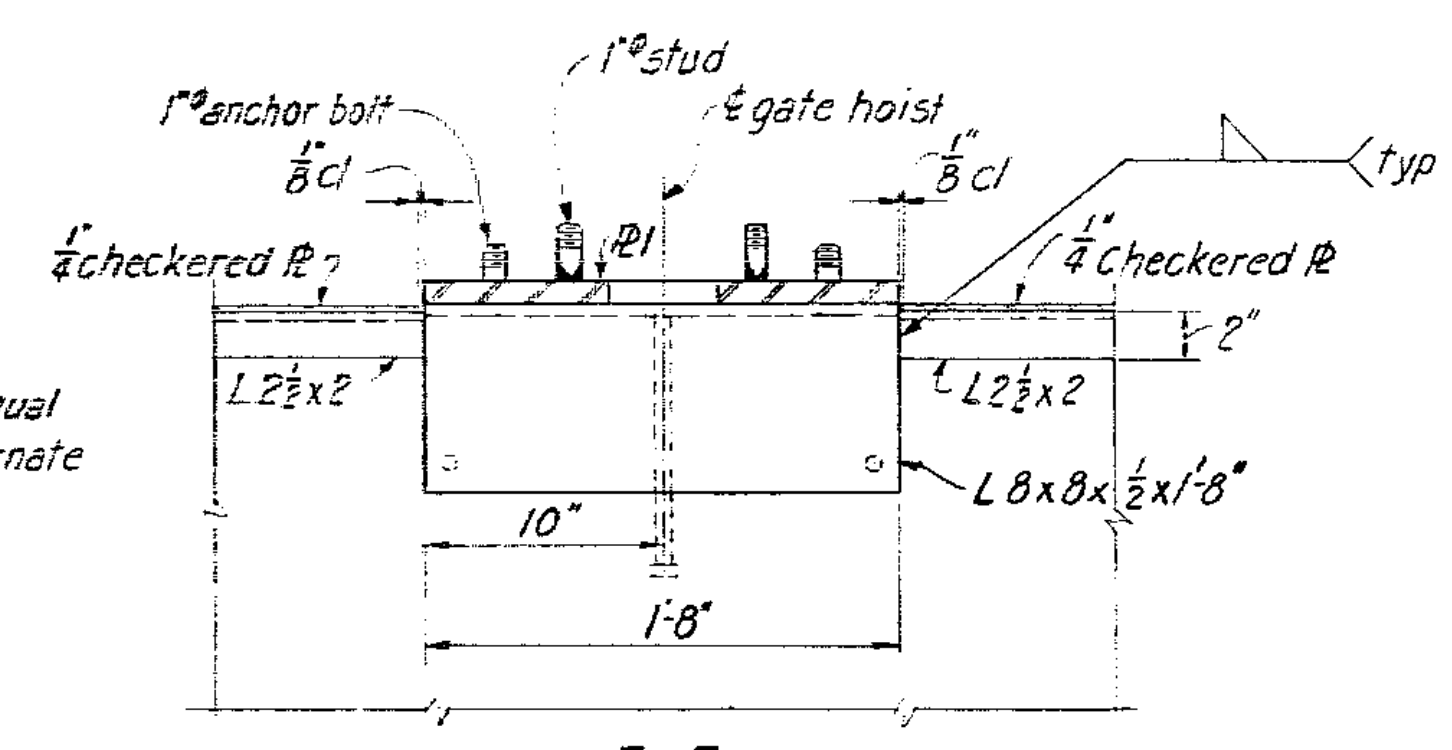

F-F

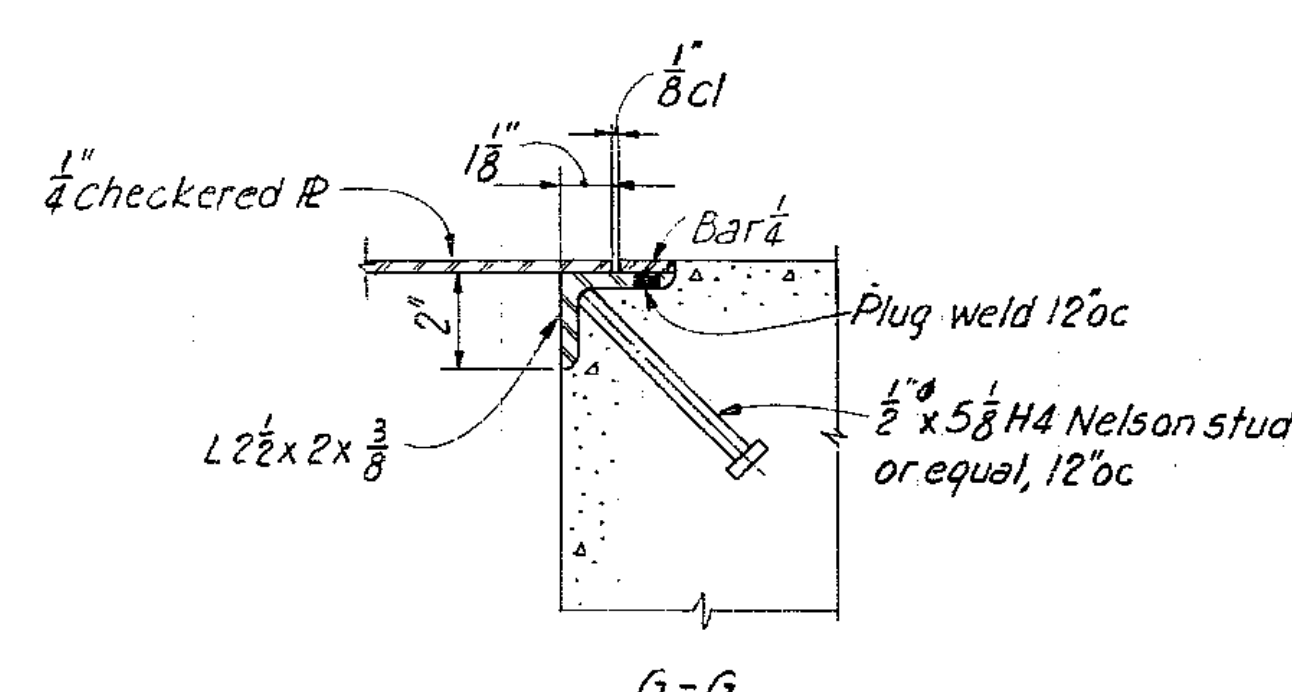

G-G

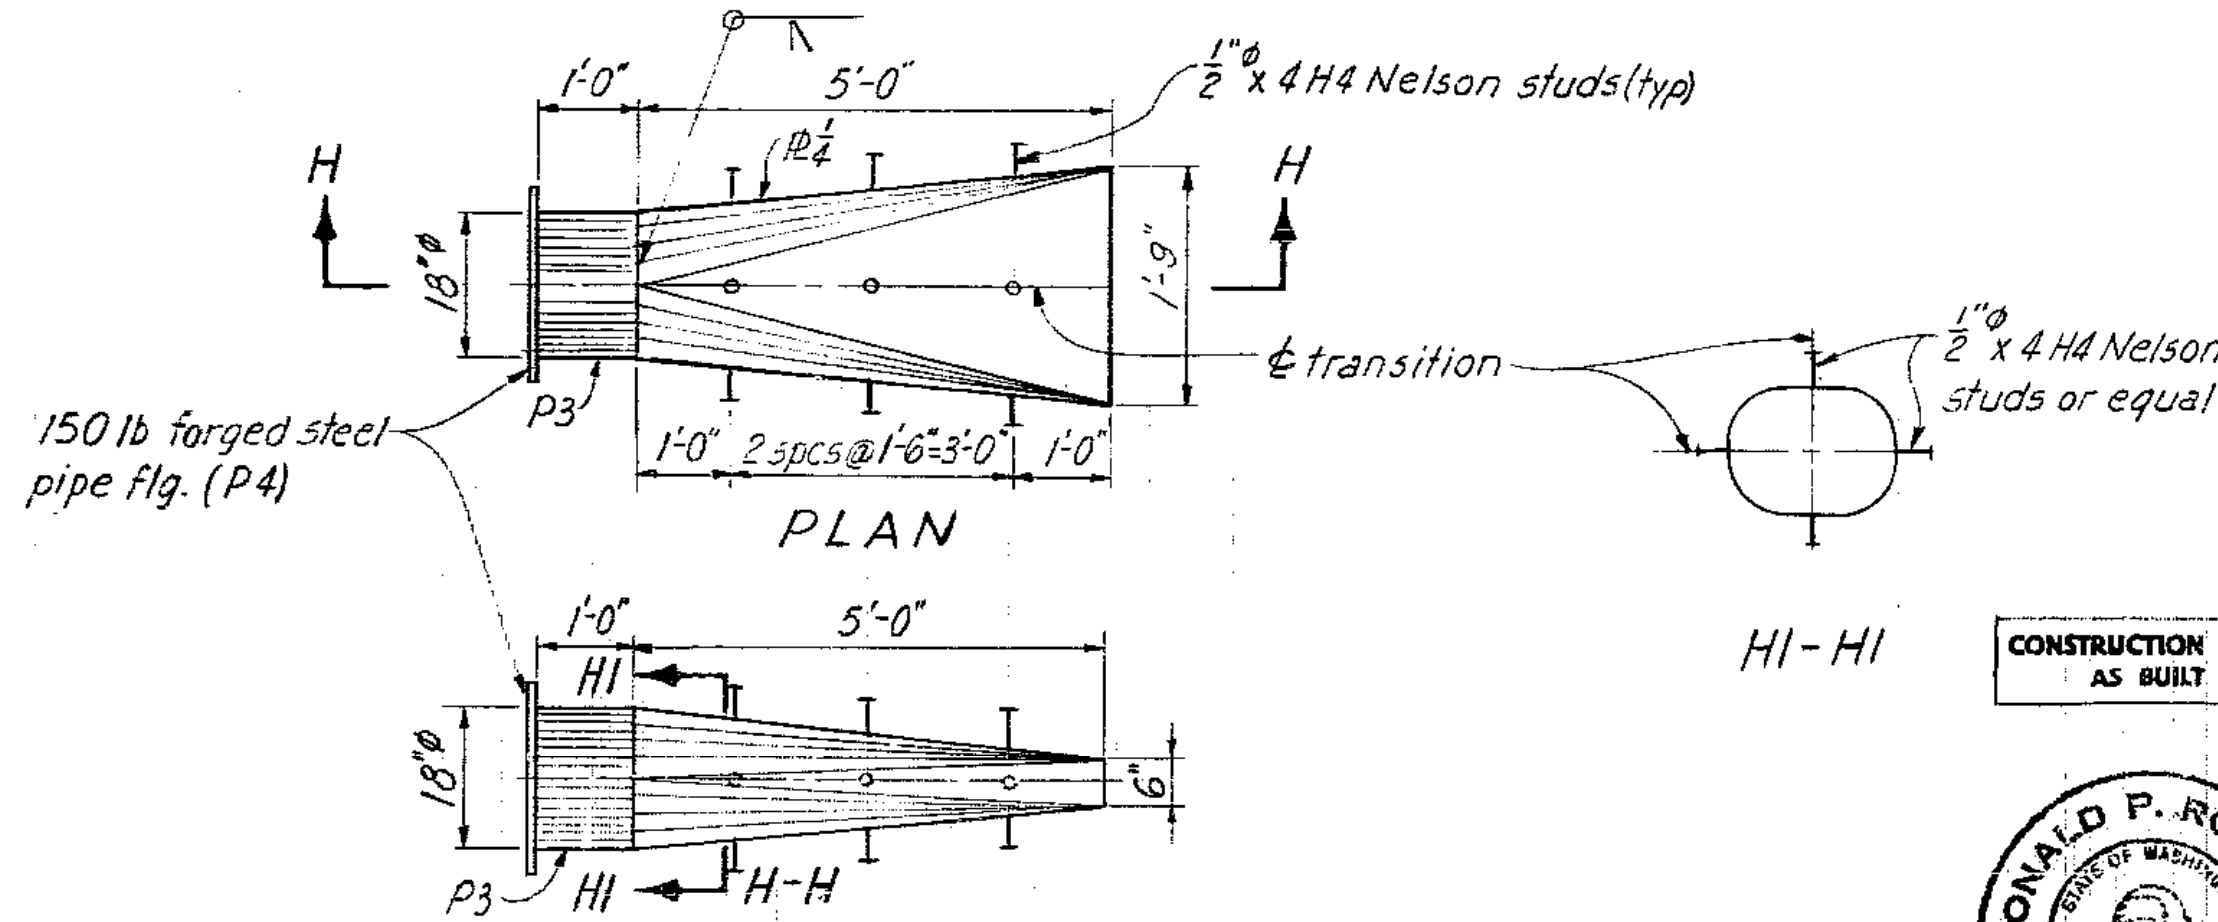



TRANSITION FOR 18" D15 MIGRANT BY-PASS PIPE
MK 2793-3 1 req'd (MA2783)

- REFERENCE DRAWINGS:
- Concrete MA2785
 - Standard Details MA 2775 & MA 2776
 - Gravity Intake Gate & Guides MA 2796
 - Auxiliary Entrance Gate and Guides - Slot Adjusting Plates MA 2797

- NOTES:
- All material for diffusion grating to be aluminum except as noted
 - CR5 denotes corrosion resistant steel

As	No Asbuilt Revisions	WJW	1/5/69
1	MA2793-3 revision - E-E, F-F Rev. stud placement 4/11/67	SNR	4/14/67
NO.	REVISION	DATE	BY
CITY OF TACOMA DEPARTMENT OF PUBLIC UTILITIES MAJOR PROJECTS DIVISION			
MOSSYROCK PROJECT SALMON HATCHERY - BARRIER DAM			
MISCELLANEOUS METALS SHEET 2			
HARZA ENGINEERING COMPANY			
DRAWN	ELK	DESIGNED	ELK
CHECKED	SWG	REVIEWED	SWG
APPROVED FOR CITY OF TACOMA AS TO GENERAL FEATURES			
TACOMA, WASHINGTON		DRAWING NUMBER	
DATE MAY 1967		MA2793 R1/AS	
SCALE None		DRAWER NO.	


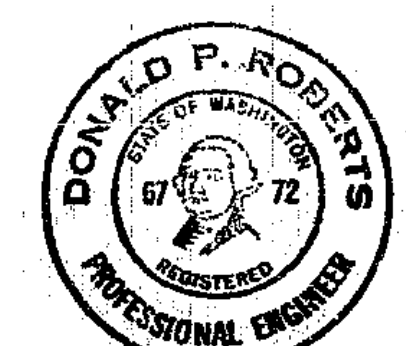


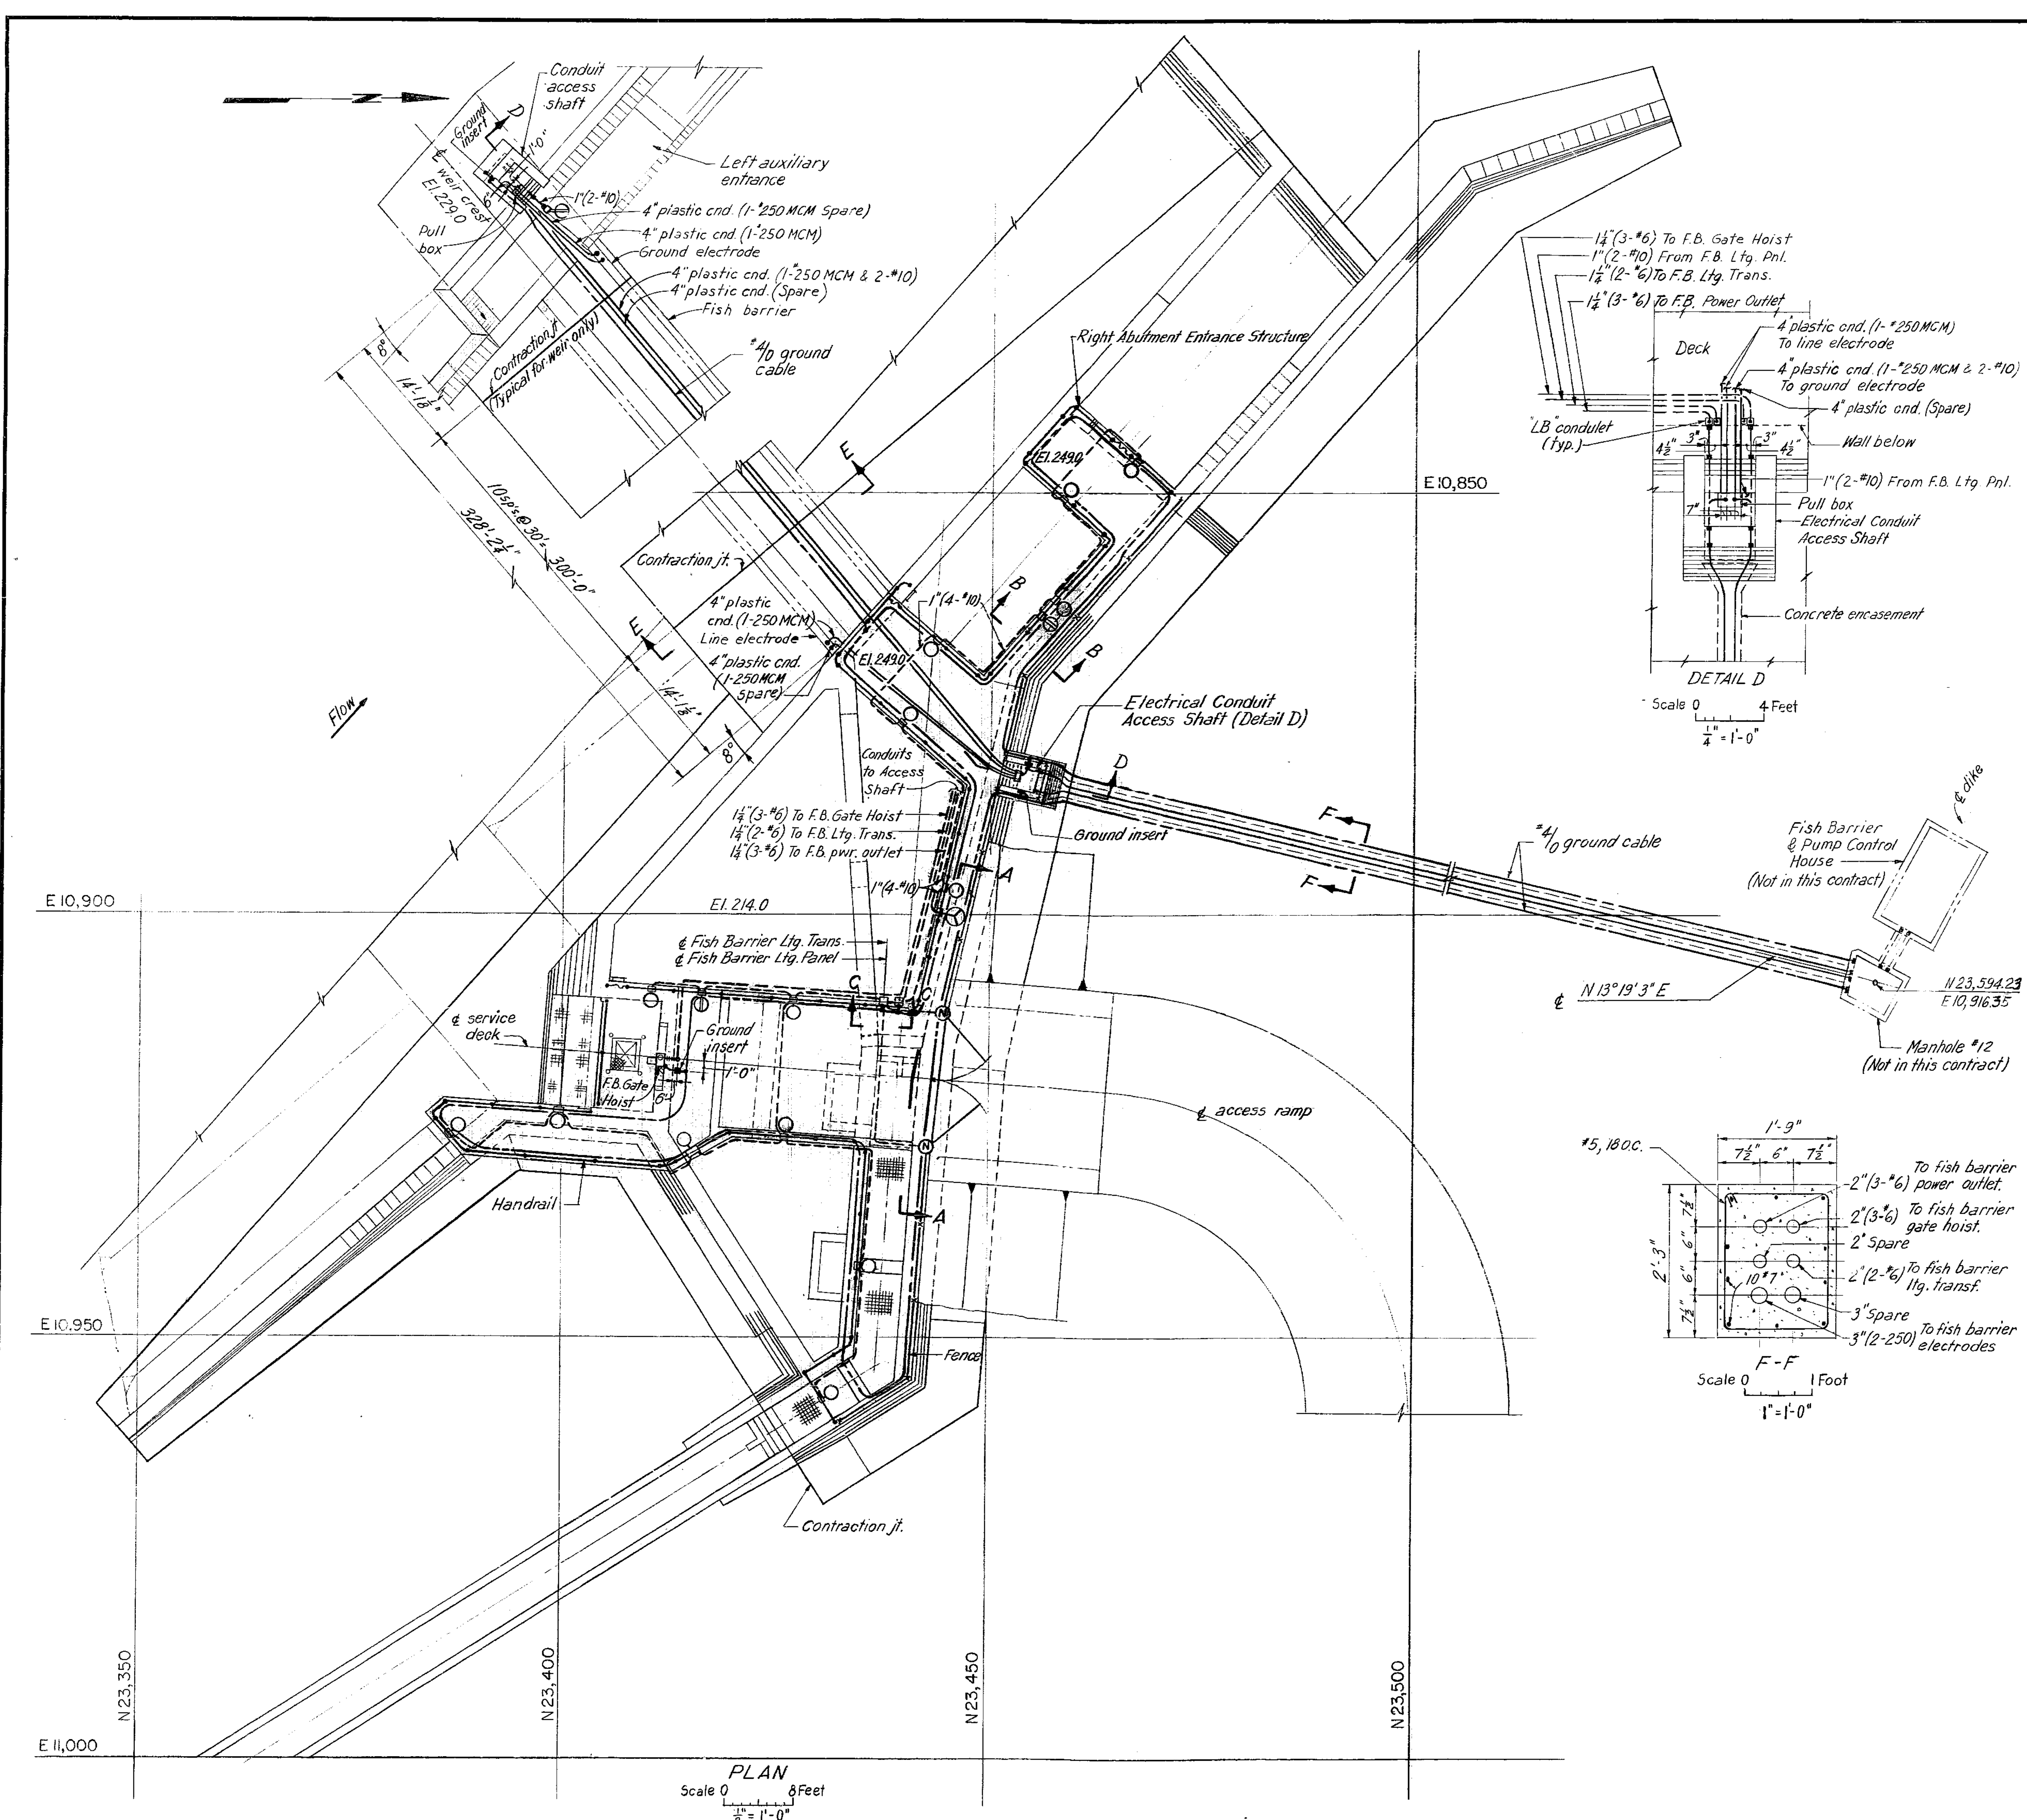

- SYMBOLS:**
- Conduit embedded or buried
 - - - Conduit exposed
 - Conduit turning toward observer
 - Conduit turning away from observer
 - Ground cable
 - Lighting fixture type "V", except where noted
 - ⊙ 120V. receptacle
 - ⊕ 440V, 3φ power outlet
 - Ground insert

REFERENCE DRAWINGS:
 Civil MA2783, MA2784, MA2785
 Mechanical MA2641

- NOTES:**
- Conduits for lighting & receptacles shall be 3/4" in size containing 2-#10 wires, unless otherwise noted.
 - Location of Fish Barrier Lighting Transformer, Panel, receptacles & fixture type "V" shall be determined in field.
 - Conduit runs to all electrical items shall be exposed as much as possible beneath the concrete slabs.
 - Conduits running from Electrical Conduit Access Shaft to Manhole #10 shall be uniformly sloped toward this manhole.
 - All conduits leaving concrete shall be terminated with conduit coupling flush with the surface.
 - All sleeves shall be plugged with flush type pipe plugs.
 - Exposed 3/4" conduits shall be supported at 5 foot intervals or less & 1" conduits & larger at 10 foot intervals or less.
 - Size of main ground cables shall be #4 AWG.
 - Ground cables buried in earth shall be laid at a minimum depth of 12 inches below finished grade.
 - If required, 1-inch diameter copperweld rods shall be driven to achieve the specified 5 ohm resistance.
 - Connections to major equipment (Lighting trans. panel etc.) shall be #20 AWG. Connections to motors and exposed metal parts shall be #6 AWG, unless otherwise noted.
 - All exposed metal parts, frames, conduits, waterpipe systems, fences, railings, etc. shall be grounded.
 - Clamp exposed ground cable to steel members at 5 feet centers & to concrete surfaces at 3 feet centers.
 - Fences & handrails shall be grounded at not over 25 foot intervals & bonded for electrical continuity.
 - Fence gates shall be grounded by the use of copper flexible braid & required connectors.
 - For other electrical requirements refer to the specifications.
 - Coil 3'-0" of each 250 MCM cable & protect against damage in this pull box. These cables are to be used in case of a failure of either line or ground electrode cables.
 - Concrete reinforcing should not come in contact with either electrode, Nelson studs or Cadweld connections.

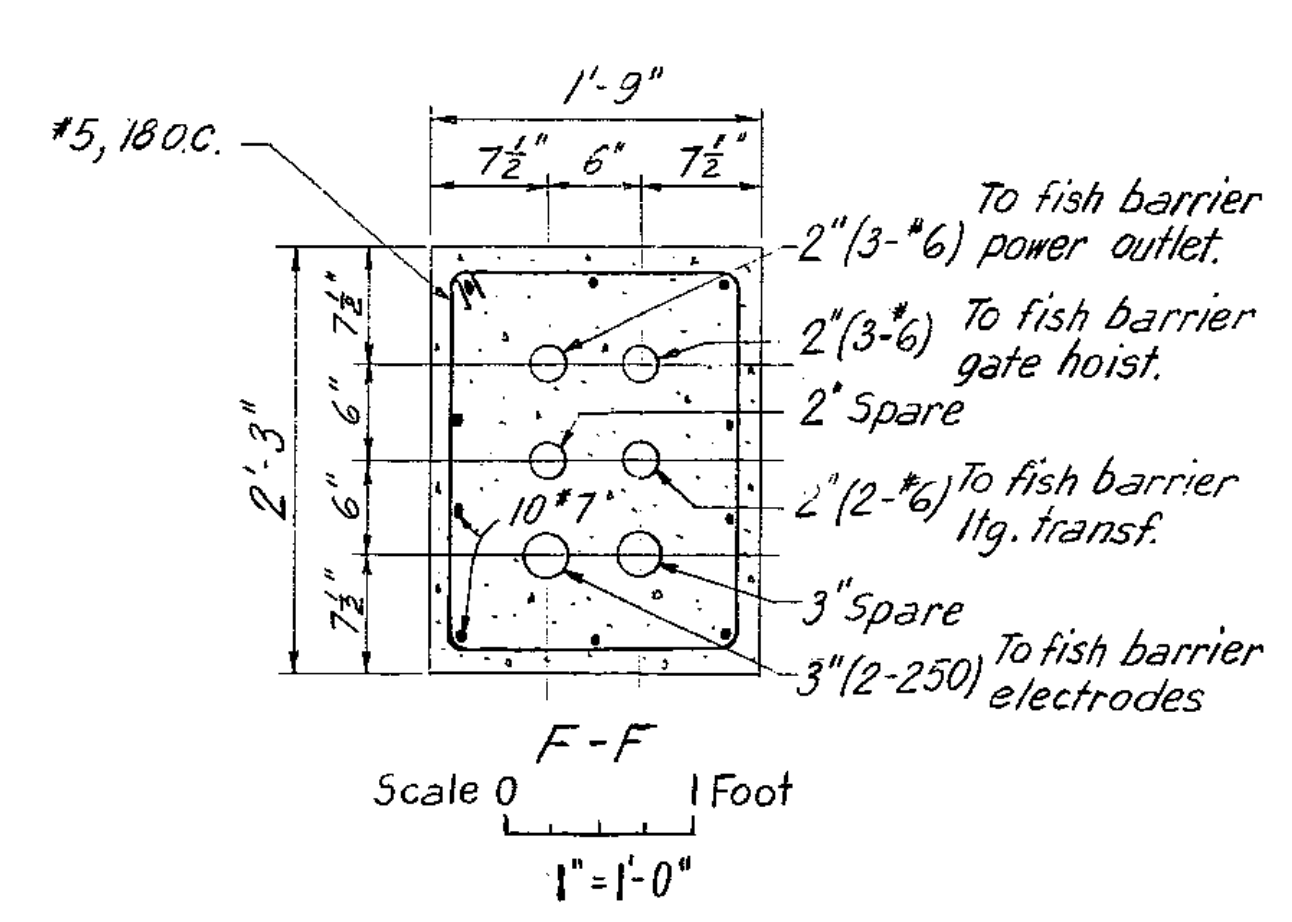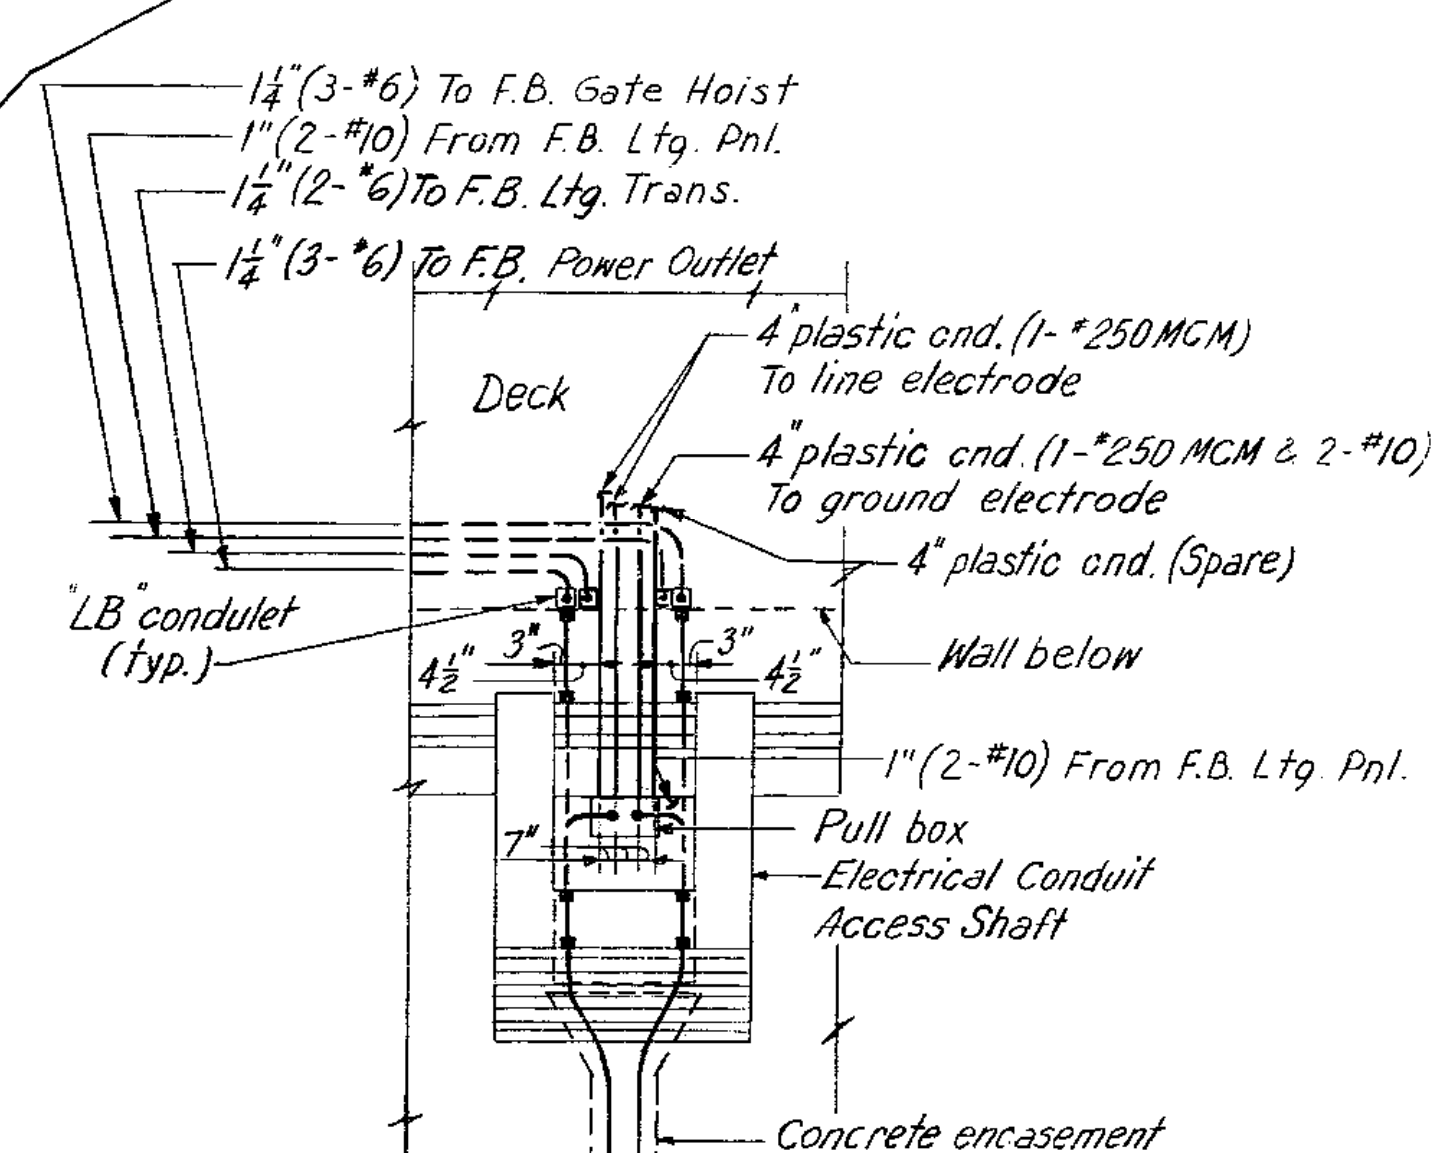

CONSTRUCTION DWG.
 AS BUILT

Scale 0 8 16 Feet
 1/8" = 1'-0"

As	Asbuilt; minor revisions				
1	General	6-21-67	D.A.H.	6-21-67	6-21-67
NO.	REVISION	DATE	BY	APP'D	DATE
CITY OF TACOMA DEPARTMENT OF PUBLIC UTILITIES MAJOR PROJECTS DIVISION					
MOSSY ROCK PROJECT SALMON HATCHERY-BARRIER DAM CONDUIT, GROUNDING & LIGHTING LAYOUT SHEET 1					
HARZA ENGINEERING COMPANY					
DRAWN	B.K.	DESIGNED	[Signature]		
CHECKED	G.K.	REVIEWED	[Signature]		
APPROVED FOR CITY OF TACOMA AS TO GENERAL FEATURES					
TACOMA, WASHINGTON		DRAWING NUMBER		PROJECT MANAGER	
SCALE As shown		DATE May 1967		MW 3797 RI /AS	

2500 CFS 8/29/2020



2500 CFS 8/29/2020



2500 CFS 8/29/2020



2500 CFS 8/29/2020



6300 CFS 6/5/2020



6300 CFS 6/5/2020



6300 CFS 6/5/2020

